


T.6N.R.35E.W.M.

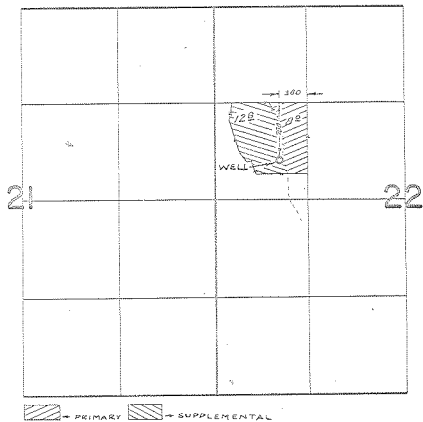

FINAL PROOF SURVEY  
UNDER

Application No. G-2555 Permit No. G-3633  
IN NAME OF

ESTATE OF PETE LOCATI

Surveyed MAY 2, 1971, by G. BACA