


T. 4 N. R. 28 E. W. M.

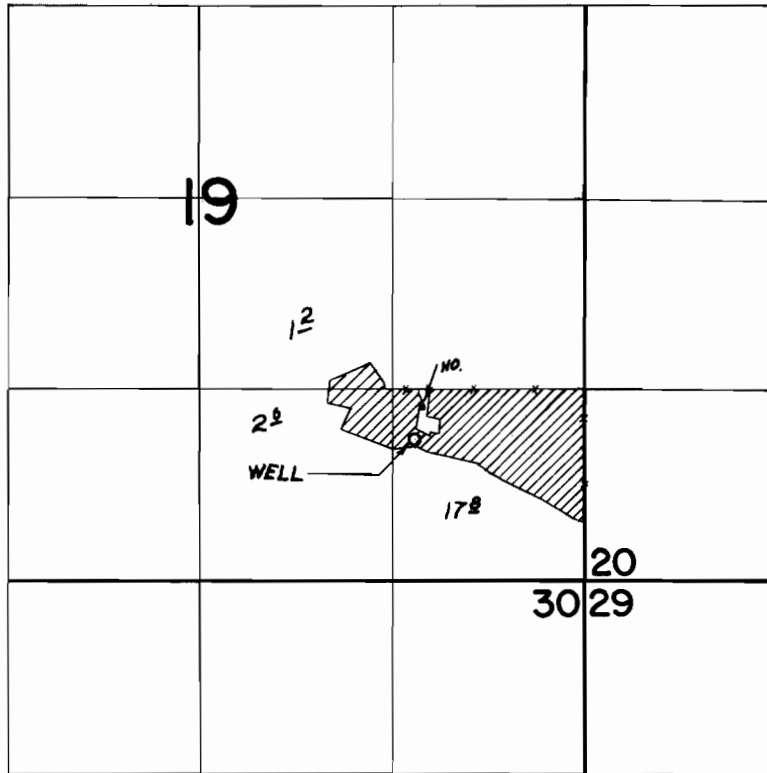

WELL LOC. 340' S & 1170' W FROM NE COR. SE 1/4 SE 1/4 SEC 19

**FINAL PROOF SURVEY**  
UNDER

Application No. G-4077 Permit No. G-3868  
IN NAME OF

.....EDGAR BLOOM.....

Surveyed AUG. 26, 1971., by L. GOULD.....