


T.6N.R.35E.W.M.

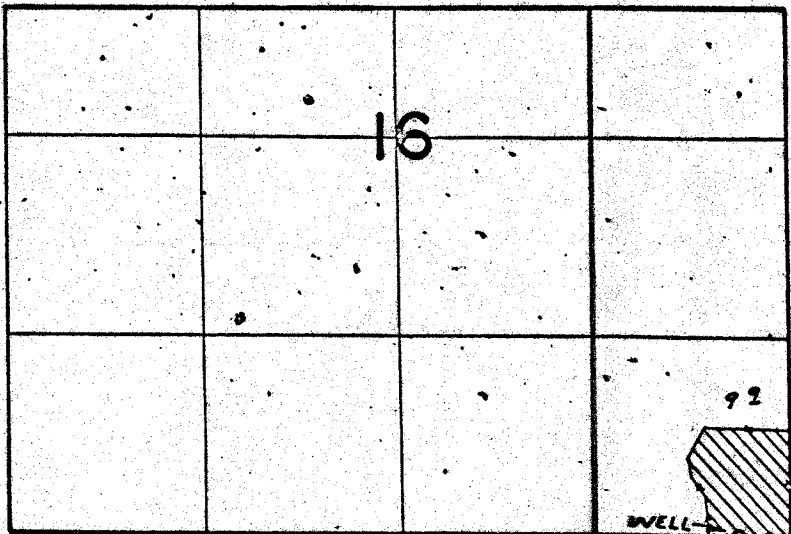

WELL LOC: 6' N. & 350' W. FROM S.E. COR. SEC. 16

FINAL PROOF SURVEY UNDER

Application No. G-4117 Permit No. G-3874
IN NAME OF

GILBERT S. TOWSLEE

Surveyed AUG. 31, 1971, by G. BACA