


Q-4331
38861
7

T.2S.R26E.W.M.

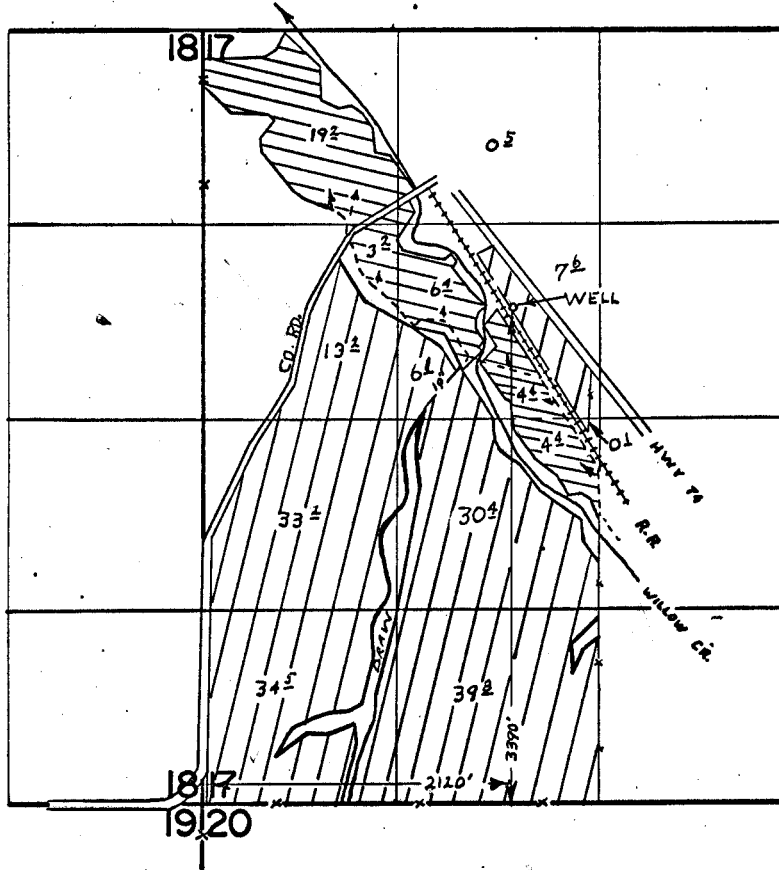

FINAL PROOF SURVEY UNDER

Application No. G-4607.. Permit No. G-4331..
IN NAME OF

JOHN F. MOLLAHAN & MILLIS I. MOLLAHAN

Surveyed JUNE 26, 1971.., by R. MUCKEN.....