


P. 29435
38862

6

T. 5 S. R. 31 E. W. M.

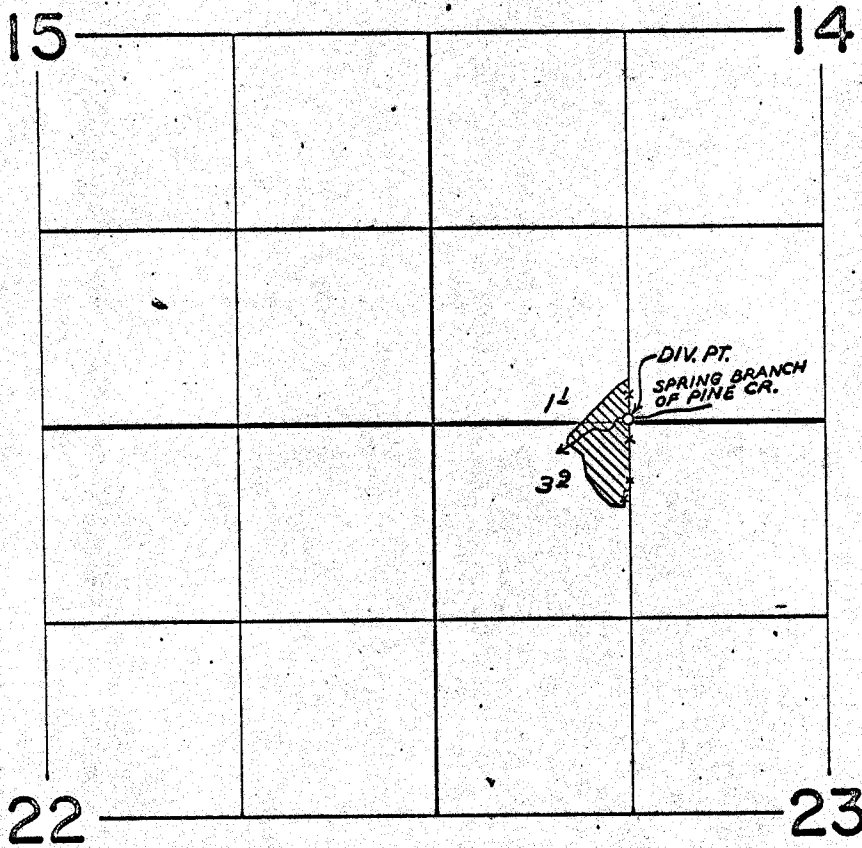

DIV. PT. LOCATED 30' N. & 10' W. FROM NE. COR. NW 1/4 NW 1/4 SEC. 23

FINAL PROOF SURVEY UNDER

Application No. 39611..... Permit No. 29435.....
IN NAME OF

R. A. FLETCHER

Surveyed JUNE 26 1971.. by GREG BACA.....