


T. 2 N. R. 32 E. W. M.

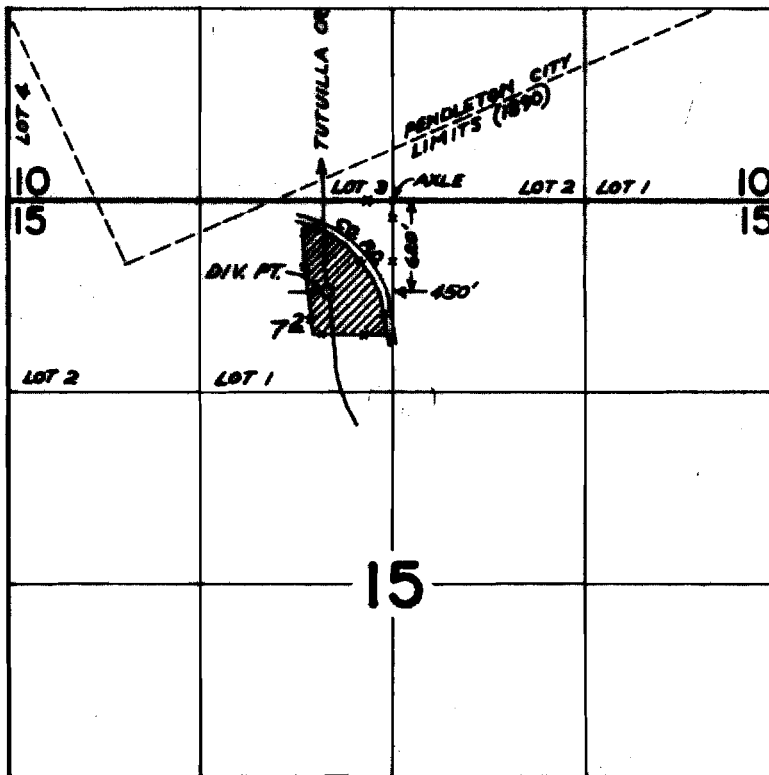

FINAL PROOF SURVEY UNDER

Application No. 42977 Permit No. 3/490
IN NAME OF

ESTATE OF JOE C. CAMPBELL

Surveyed JUNE 26 1971, by GREG BACA