


# T.6N.R.34E.W.M.

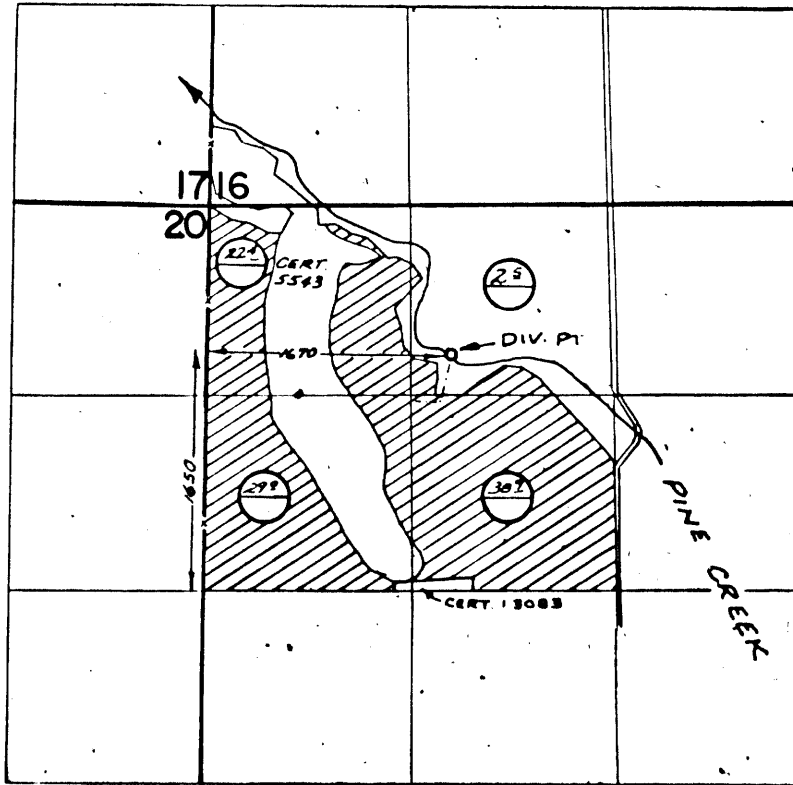

## FINAL PROOF SURVEY UNDER

Application No. 40042 Permit No. 22850  
IN NAME OF

MERLE H. YOUNG

Surveyed AUG. 27, 1971, by G. BACA