


# T.5 & 6N.R.35 & 36E.W.M.

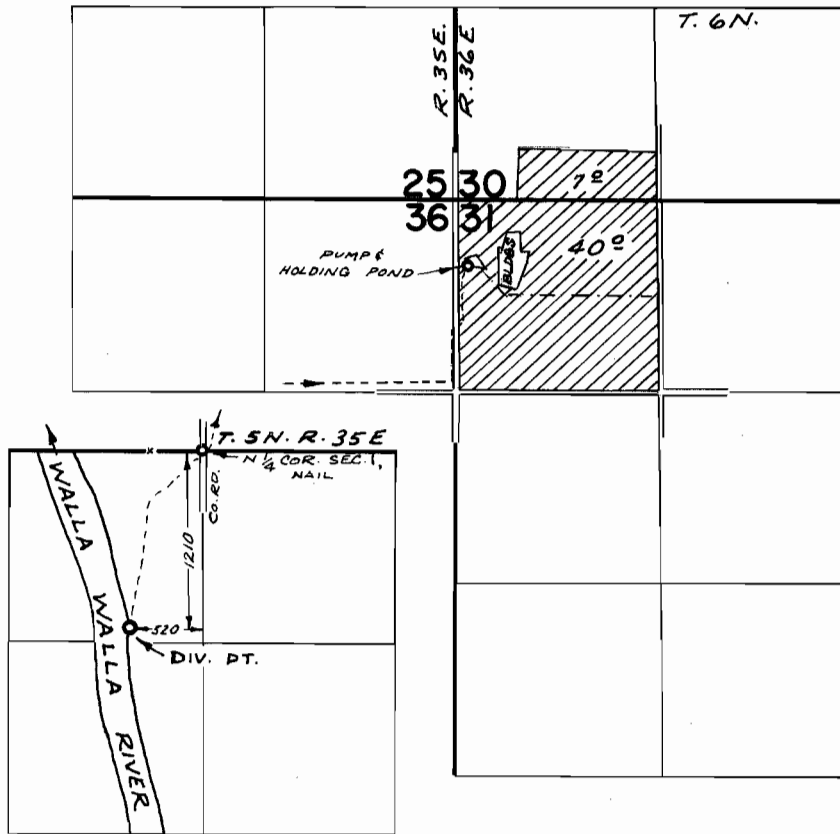

## FINAL PROOF SURVEY UNDER

Application No. 41643 Permit No. 31079  
IN NAME OF

CHARLES R. NELSON

Surveyed SEPT. 1, 2 1971, by G. BACA