


T. 4 N. R. 29 E. W. M.

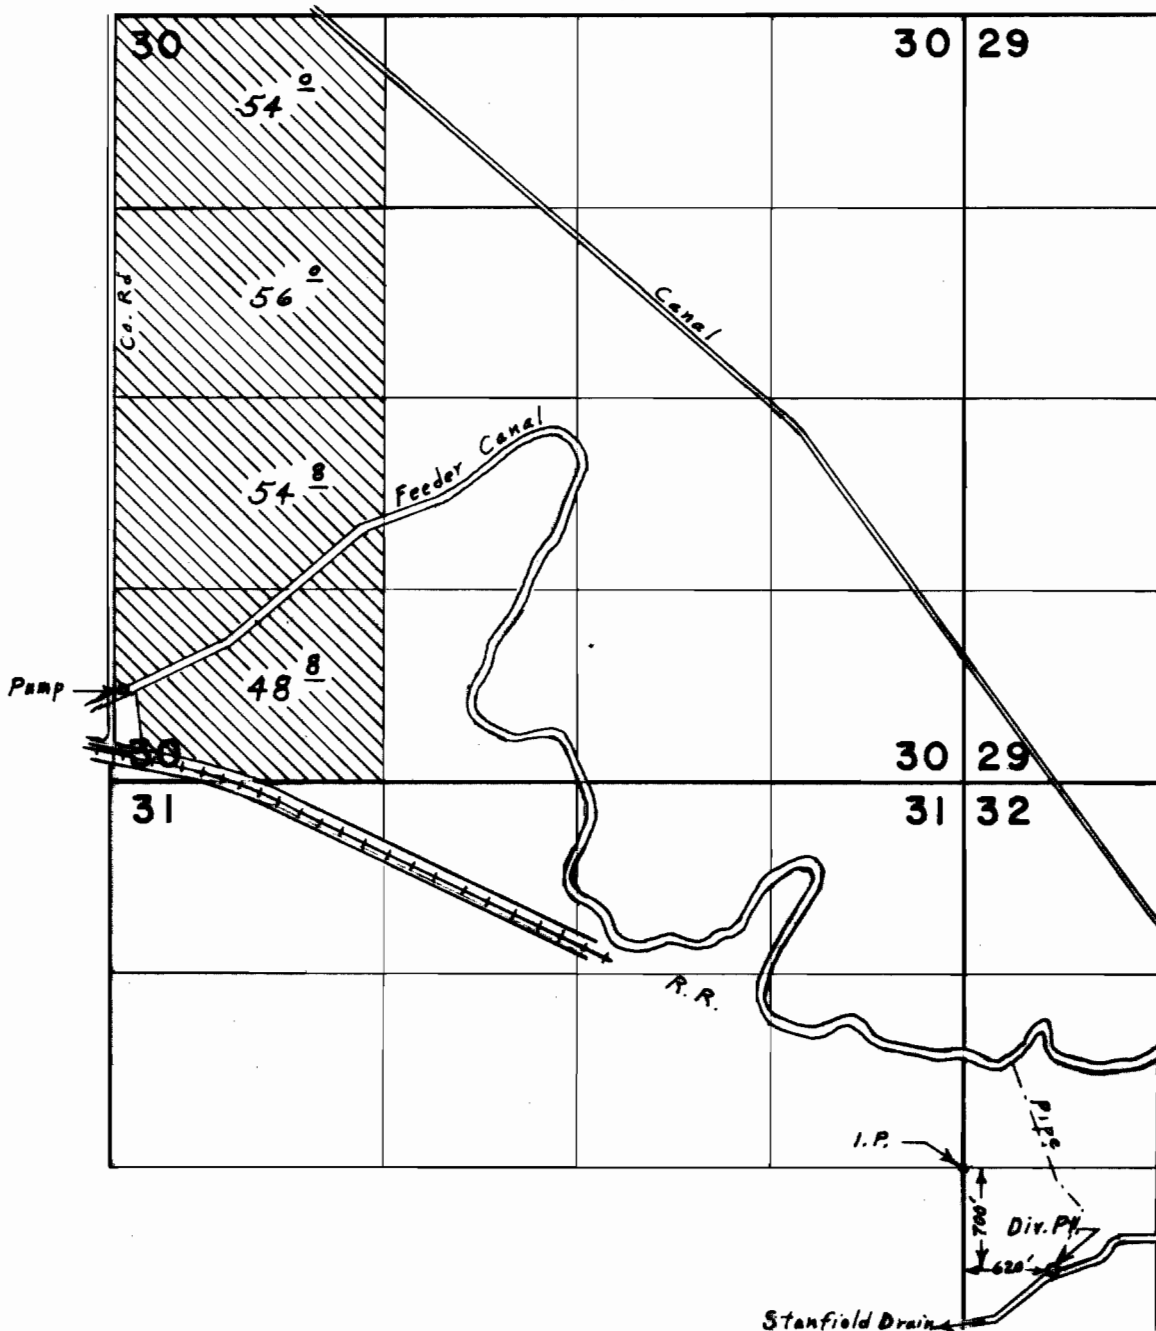

FINAL PROOF SURVEY UNDER

Application No. 41443... Permit No. 31223...
IN NAME OF

ALBERT L. & RALPH J. SEIBEL

Surveyed Aug. 27 1971., by L. E. Gould.