


T.6N.R.35E.W.M.

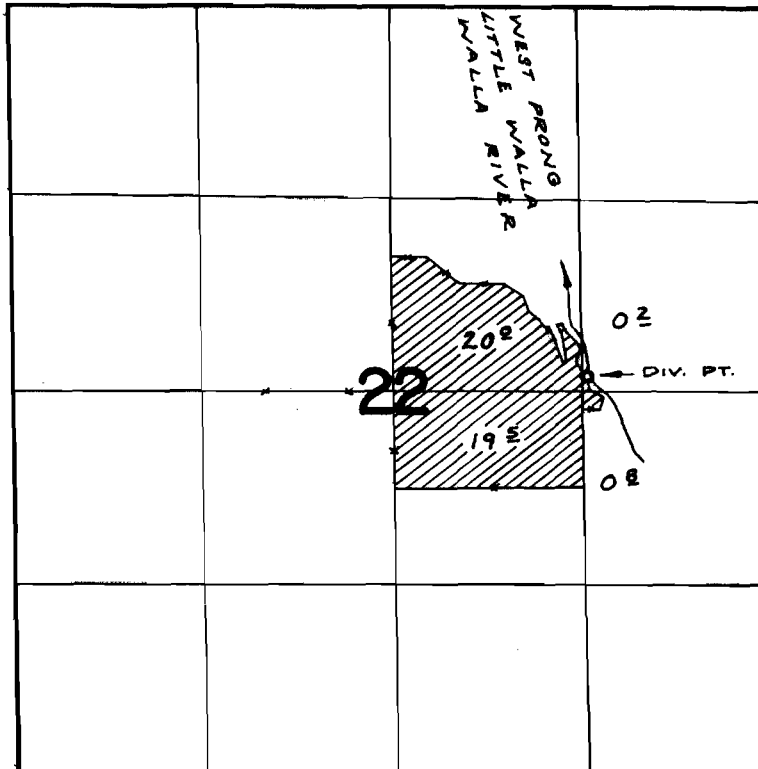

DIV. PT. 600' 100' N. & 1330' E. FROM CENTER SEC. 22

FINAL PROOF SURVEY
UNDER

Application No. 42048 Permit No. 31474
IN NAME OF

JOHN MILLER

Surveyed Aug. 21, 1971, by G. BAGA