T. 2 N. R. 30 E. W. M.

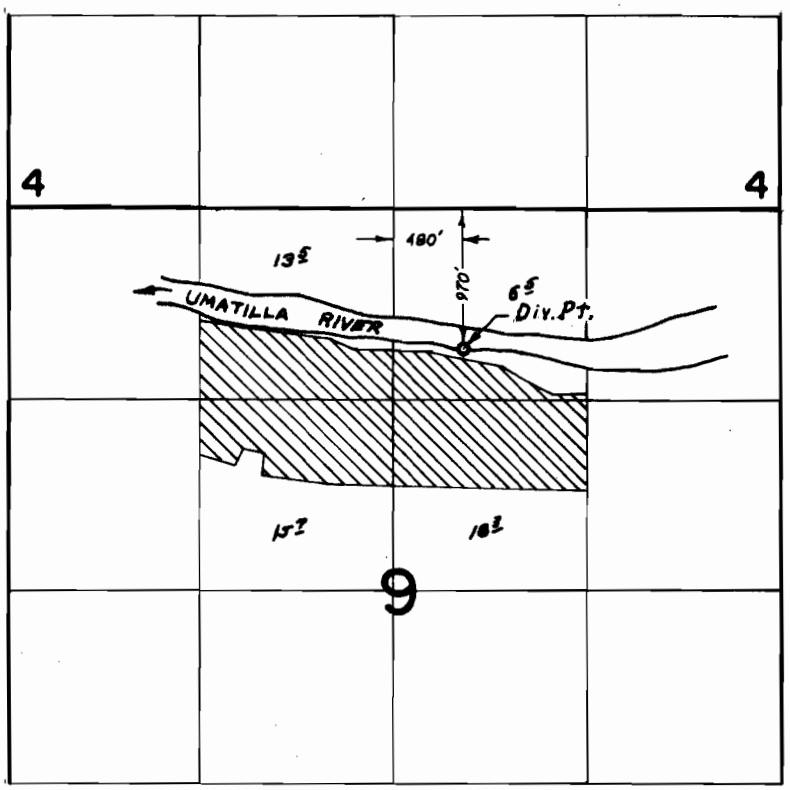

FINAL PROOF SURVEY
UNDER

Application No. 43181 Permit No. 32136
IN NAME OF

SIDNEY GALLOWAY

Surveyed NOV. 4, 1971, by L. E. Gould

NZ - 1F - 18 TJP