


# T. 4 N. R. 28 E. W. M.

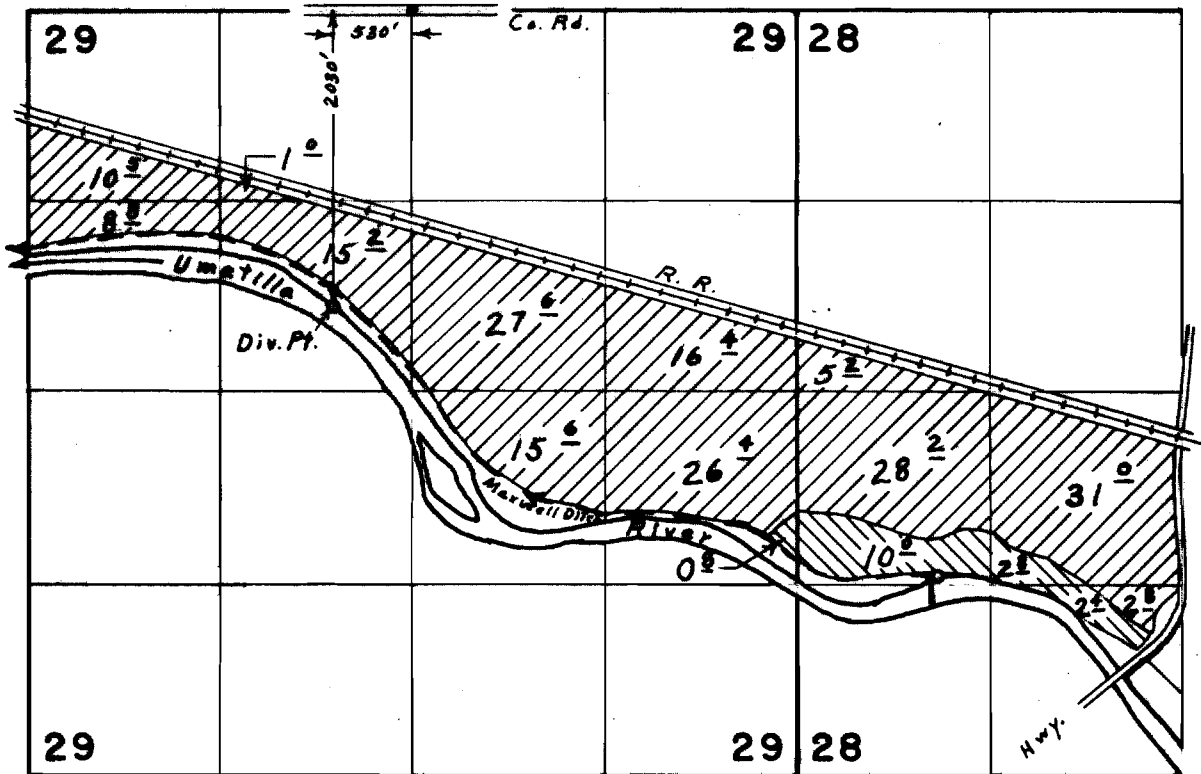

## FINAL PROOF SURVEY UNDER

Application No. 44047 Permit No. 32917  
IN NAME OF

CLARENCE FREDRICKSON

Surveyed Sept. 1, 1971, by L. E. Gould