


T. 2 N. R. 30. E. W. M

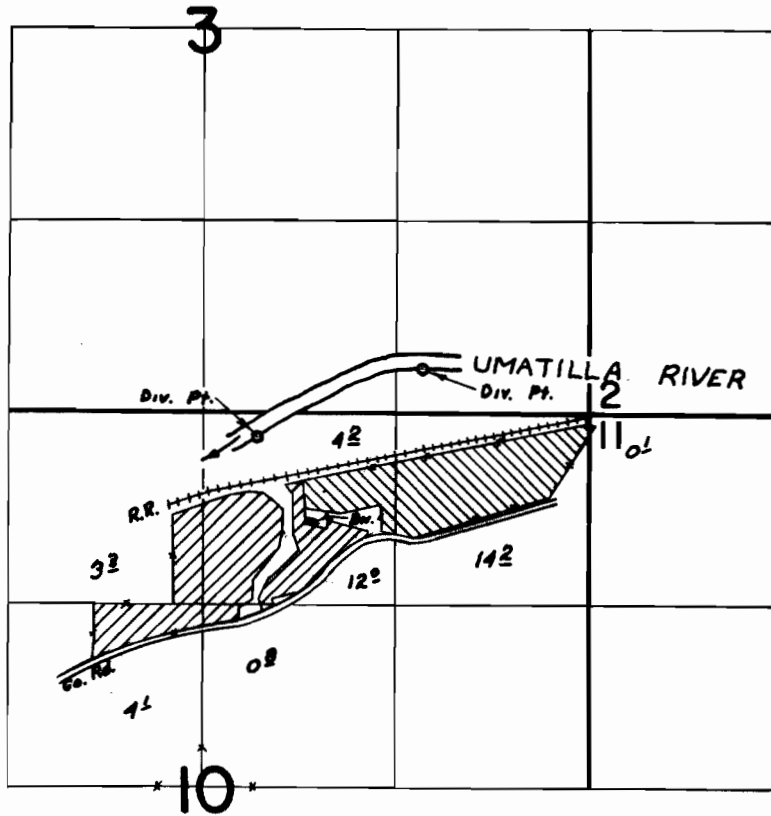

APPL. 44154



APPL. 40076

DIV. PTS. LOC. 2410 N & 380' E ; 2880' N & 1500' E
BOTH FROM CENTER SEC. 10

FINAL PROOF SURVEY UNDER

Application No. 40076 Permit No. 29867
44154 32973
IN NAME OF

THEODORE A. HENDRICKSON

Surveyed NOV. 4, 1971, by L. E. Gould