


#29983

# T.I.N.R.I.I.E.W.M.

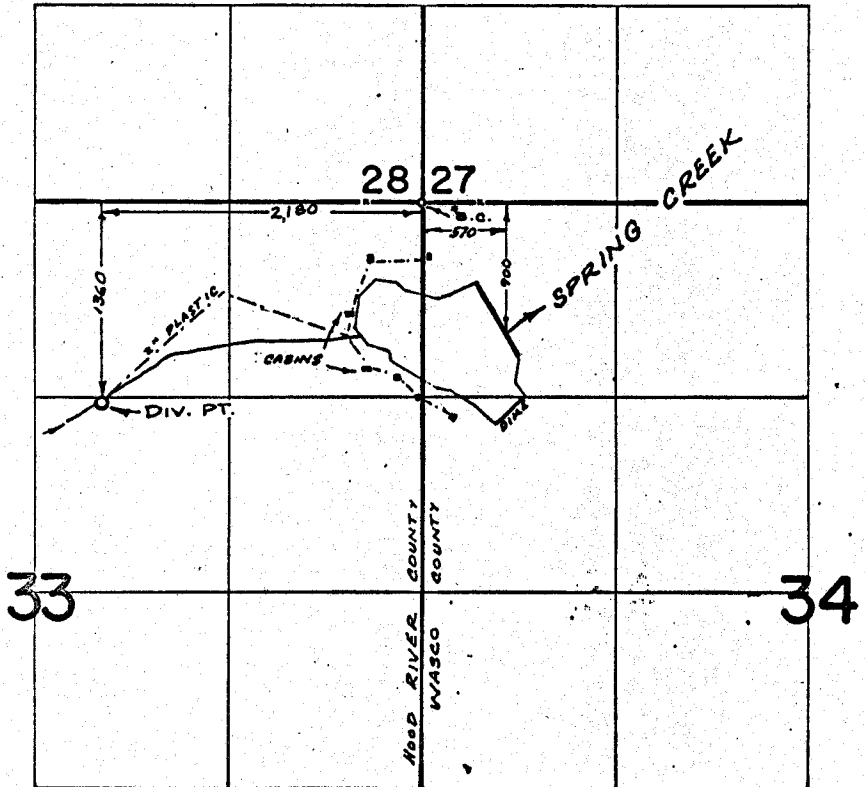

## FINAL PROOF SURVEY UNDER

Application No. R-40191 40192 Permit No. R-4488 29983

IN NAME OF

WILLIAM D. KETCHUM

Surveyed May 25, 1971, by R. MUCKEN