


#29983

T.I.N.R.I.I.E.W.M.

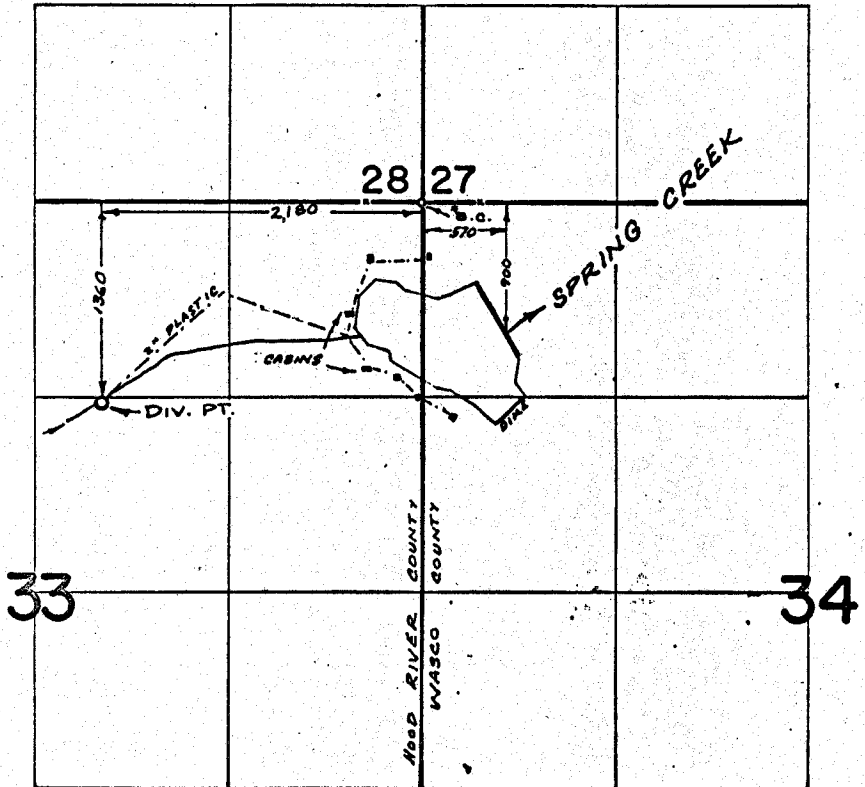

FINAL PROOF SURVEY UNDER

Application No. R-40191 40192 Permit No. R-4488 27763

IN NAME OF

WILLIAM D. KETCHUM

Surveyed May 25, 1971, by R. MUCKEN