


30334  
38880

6

T.7S.R.19E.W.M.

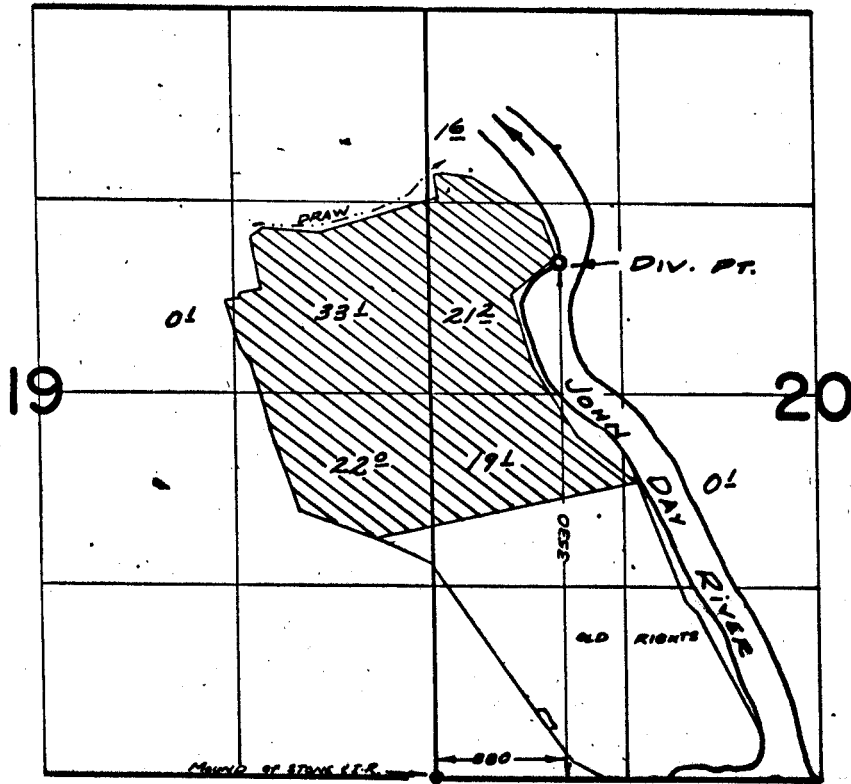

**FINAL PROOF SURVEY**  
UNDER

Application No. 40724 Permit No. 30334  
IN NAME OF

RODNEY P. ROLFE

Surveyed Nov. 21 1971, by R. MUCKEN