


T. 2 S. R. 3 W. W. M.

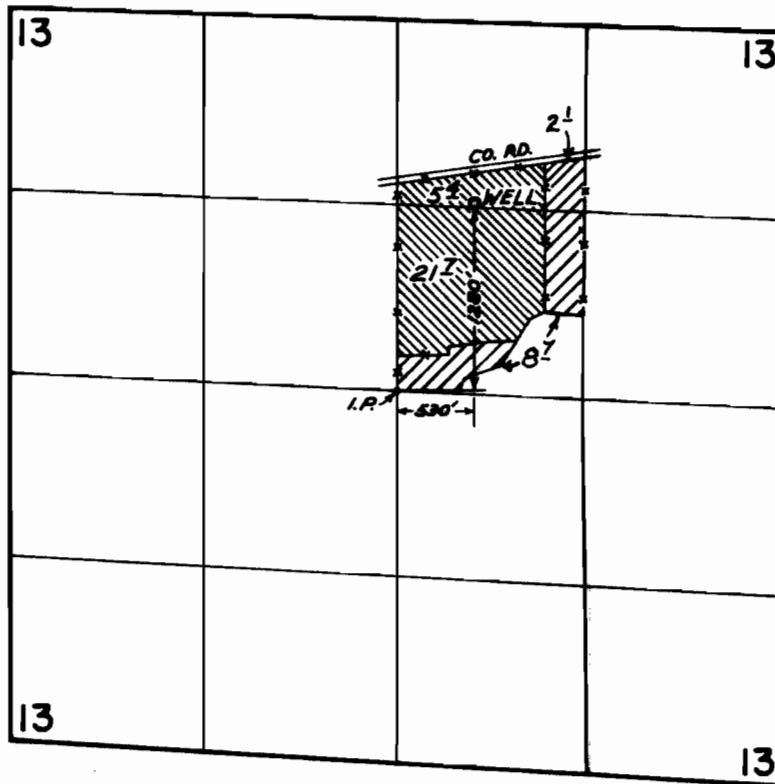

FINAL PROOF SURVEY UNDER

Application No. ~~G-4321~~ ^{G-6073} Permit No. ~~G-4044~~ ^{G-5760} 
IN NAME OF

..... DONALD D. ROGOWSKI

Surveyed ^{OCT. 5/31 1977} ~~SEPT. 17. 1971.~~ by ^{J. S. DONALDSON} ~~GREG BACA~~.....