


# T. 3 S. R. 1 W. W. M.

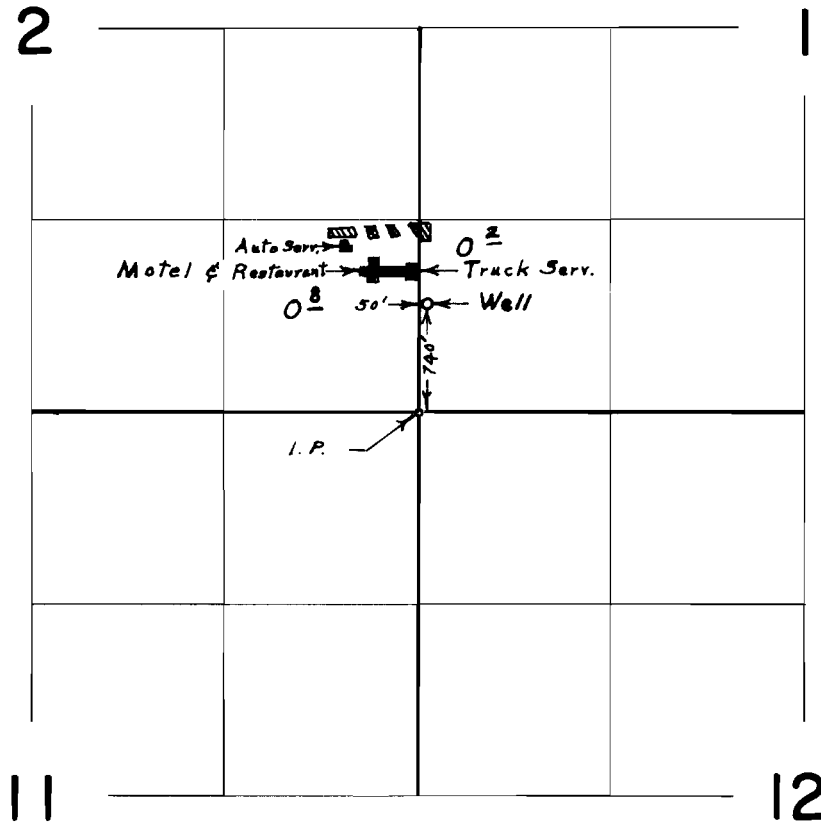

## FINAL PROOF SURVEY UNDER

Application No. G-4904 Permit No. G-4622  
IN NAME OF

BURNS BROS. INC.

Surveyed Nov. 18, 1971, by J. E. Gould