


T. 3 S. R. 18 2 W. W. M.

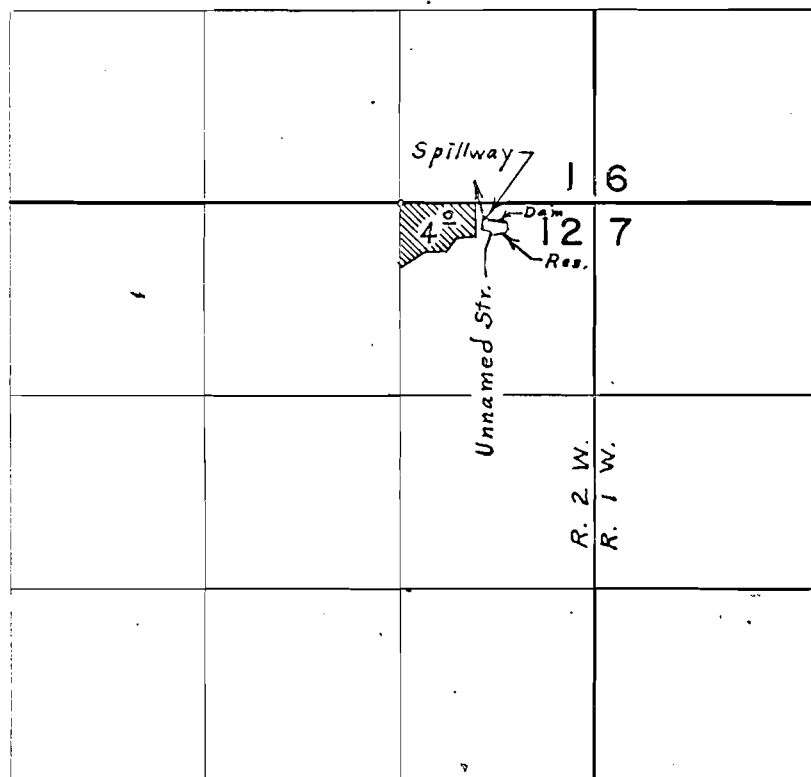

Div. Pt. located 100' S. & 570' E. from N.W. Cor. N.E. $\frac{1}{4}$ N.E. $\frac{1}{4}$ Sec. 12

FINAL PROOF SURVEY UNDER

R-40035 R-4356
Application No. 40036 Permit No. 29845
IN NAME OF

WALTER E. LOEWEN

Surveyed Nov. 18, 1971, by L. E. Gould