


T. 1 S. R. 3 W. W. M.

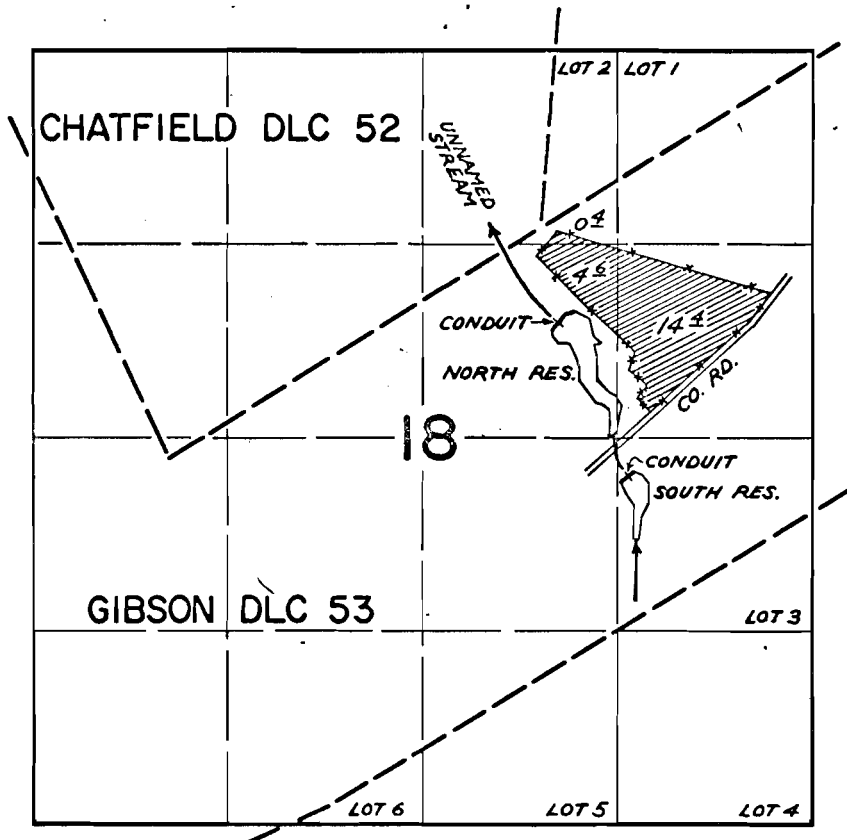

DIY PTS. LOCATED: NORTH RES. 650' S. & 120' E.; SOUTH RES. 1690' S. & 590' E.; BOTH FROM MOST EASTERLY SE. COR. CHATFIELD DLC 52

FINAL PROOF SURVEY  
UNDER

Application No. R-41122 Permit No. R-4618  
41123 30658  
IN NAME OF

MARNIS A. CRIPPEN

Surveyed SEPT. 16 & 17 1971, by GREG BACA