


# T. I. S. R. 2 W. W. M.

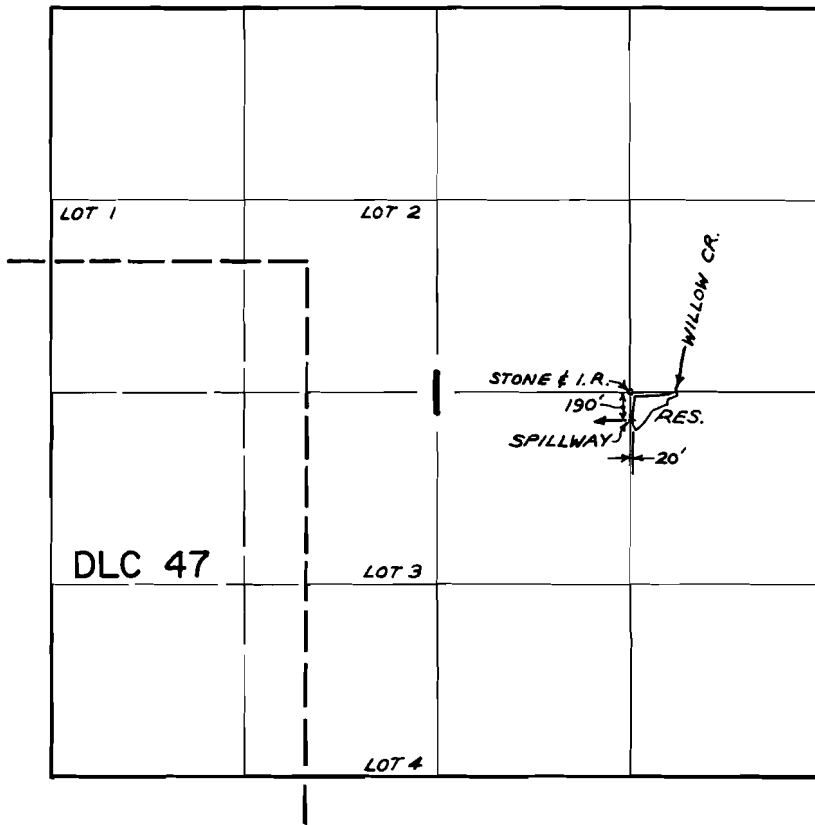

## FINAL PROOF SURVEY UNDER

Application No. R-42770 ~~42771~~ Permit No. R-4737 ~~31263~~  
IN NAME OF

CARL PETERS

Surveyed SEPT. 14 1971, by GREG BACA