


T. I N. & S. R. 2 W. W. M.

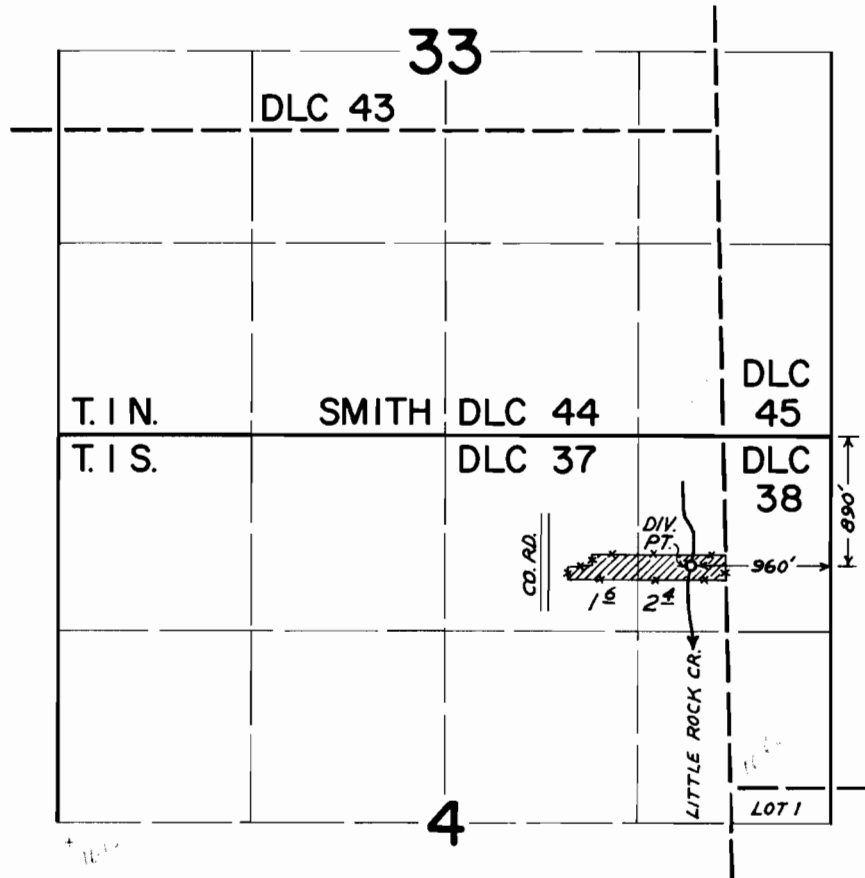

FINAL PROOF SURVEY UNDER

Application No. 42690 Permit No. 3/900
IN NAME OF

JOE STROEDER

Surveyed SEPT. 15 1971, by GREG BACA