


T. 1 S. R. 3 W. W. M.

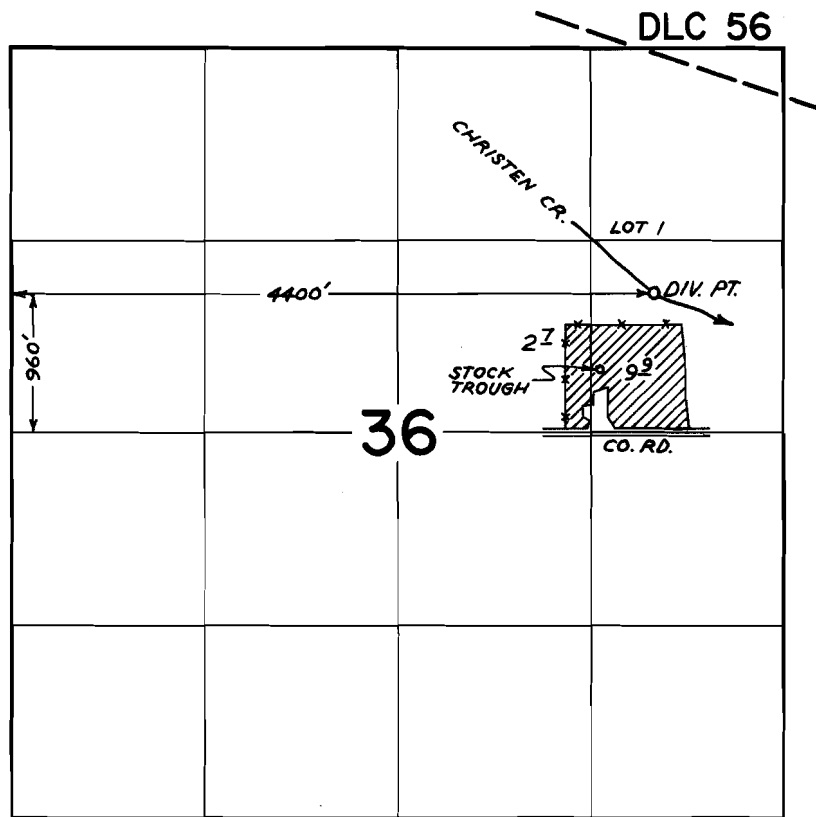

FINAL PROOF SURVEY UNDER

Application No. 43526 Permit No. 32564
IN NAME OF

THOMAS MILTON OLSEN

Surveyed SEPT. 16, 1971, by GREG BACA