


T. 2 & 3 S. R. 2 W. W. M.

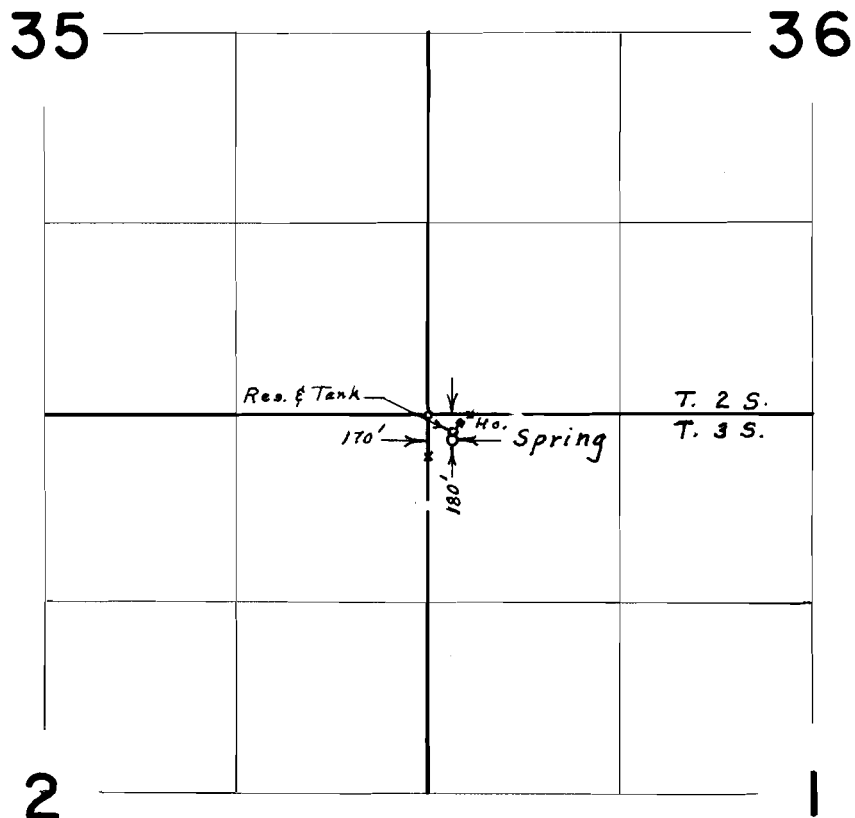

FINAL PROOF SURVEY
UNDER

Application No. 43543 Permit No. 32572
IN NAME OF

KENNETH L. HANKINS

Surveyed Sept. 29, 1971, by L. E. Gould