


T. 1 N. R. 3 W. W. M.

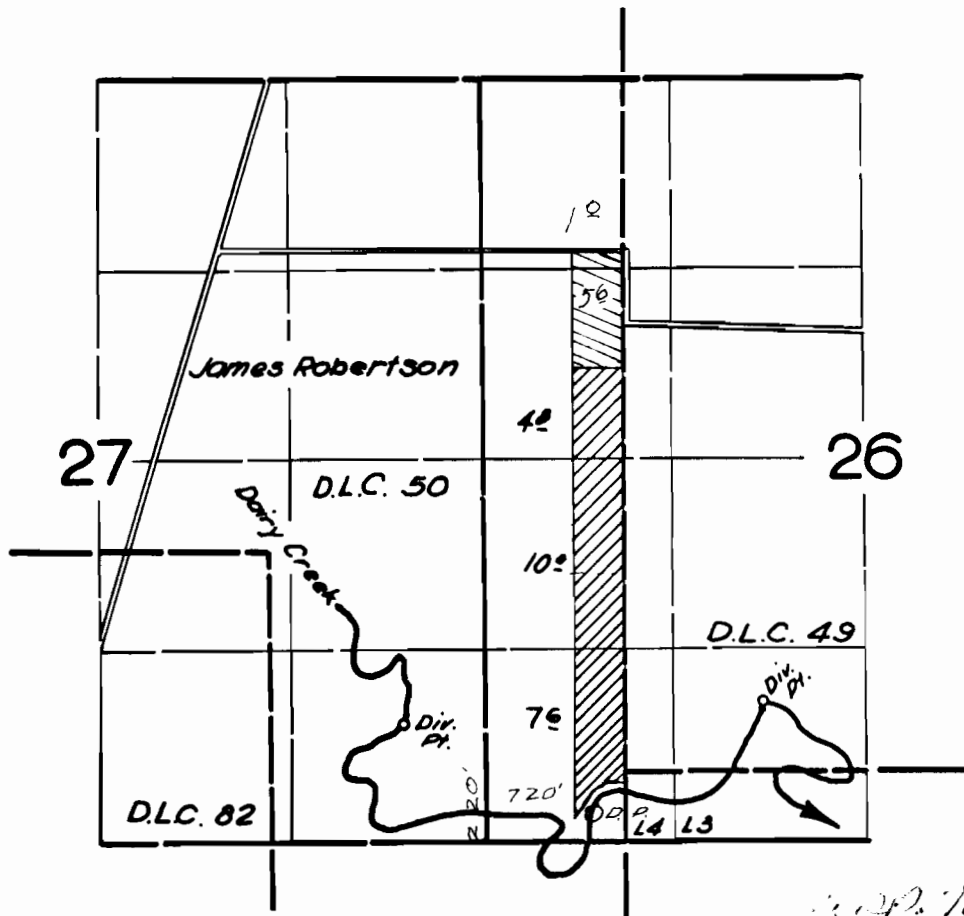

Map No. 706, 44816
Sec. 26, 33519

FINAL PROOF SURVEY
UNDER

Application No. 31051 ... Permit No. 24399.
IN NAME OF

CECIL N. KINDEL

Surveyed 26 May 1959, by R. Jackson