


T. 1 N. R. 3 W. W. M.

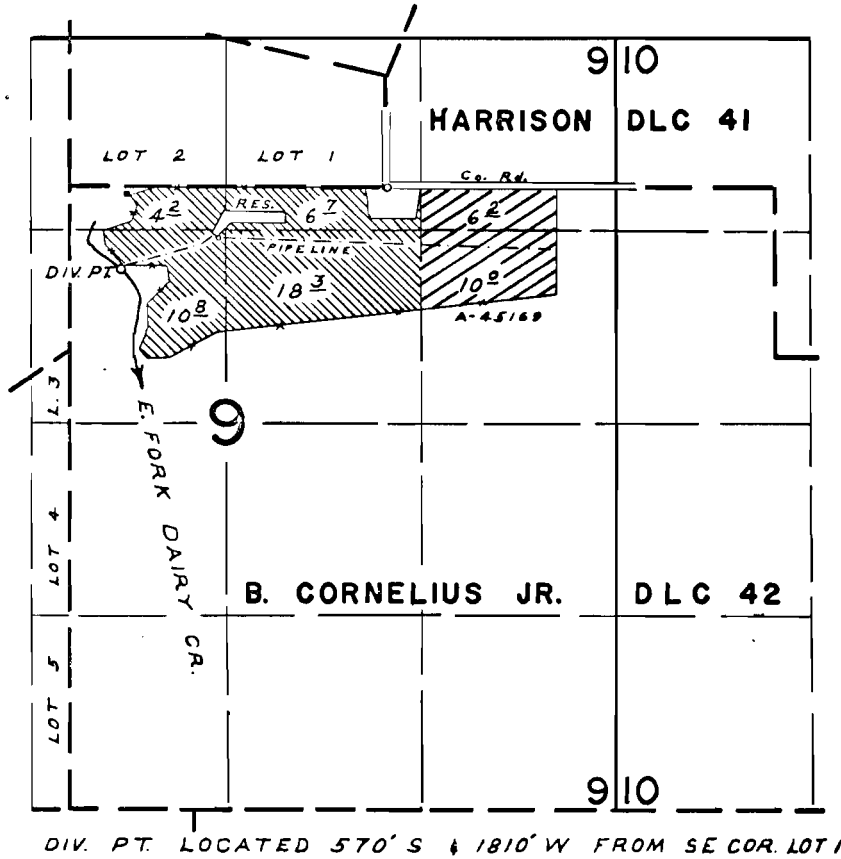

FINAL PROOF SURVEY
UNDER

45169 *33735*
R-45085 *R-5324*
Application No. **40795** Permit No. **30793**
IN NAME OF

WILLIAM J. or EVELYN M. BRAUKMANN

Surveyed **OCT. 8 1968**, by **W. J. RUPPERT**