


T. 3 S. R 2 W. W. M.

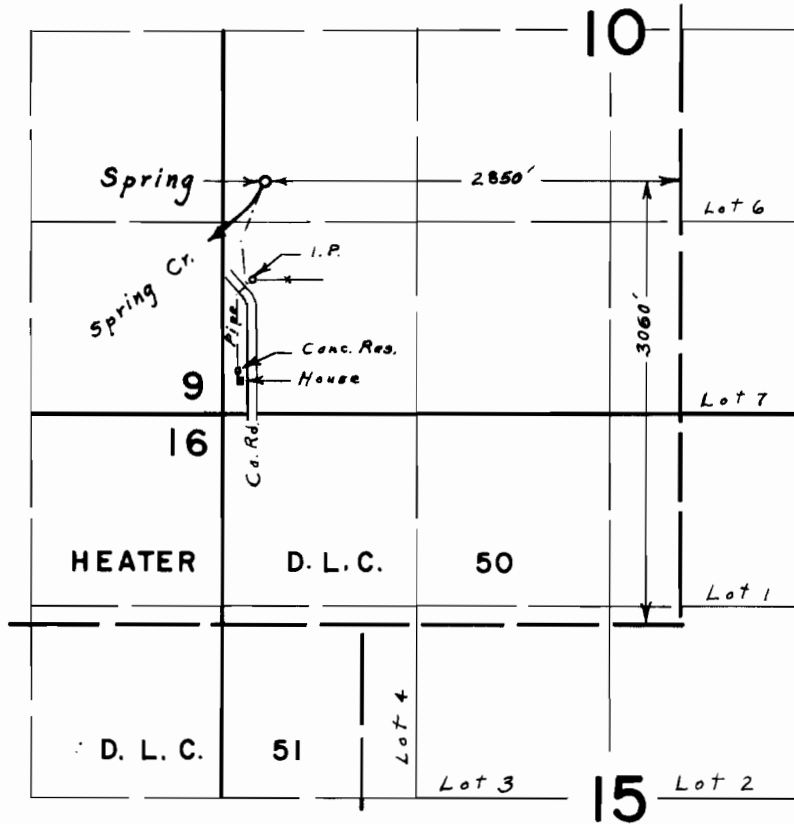

**FINAL PROOF SURVEY**  
**UNDER**

Application No. 39037 Permit No. 29212  
IN NAME OF

JOHN R. DAVID

Surveyed July 29, 1971, by L. E. Gould.