


# T. 3 S. R. 5 W. W. M.

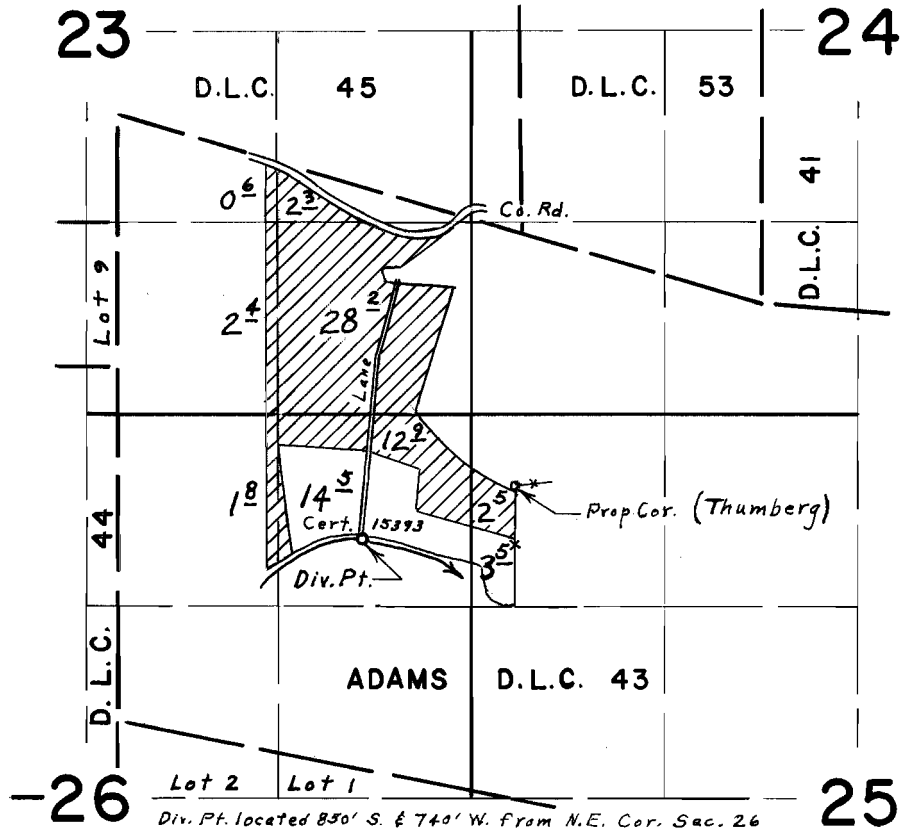

## FINAL PROOF SURVEY UNDER

Application No. 40043 Permit No. 29851  
IN NAME OF

HAROLD PAYNE

Surveyed Oct. 29, 1971, by L. E. Gould