


# T. 3 S. R. 4 & 5 W. W. M.

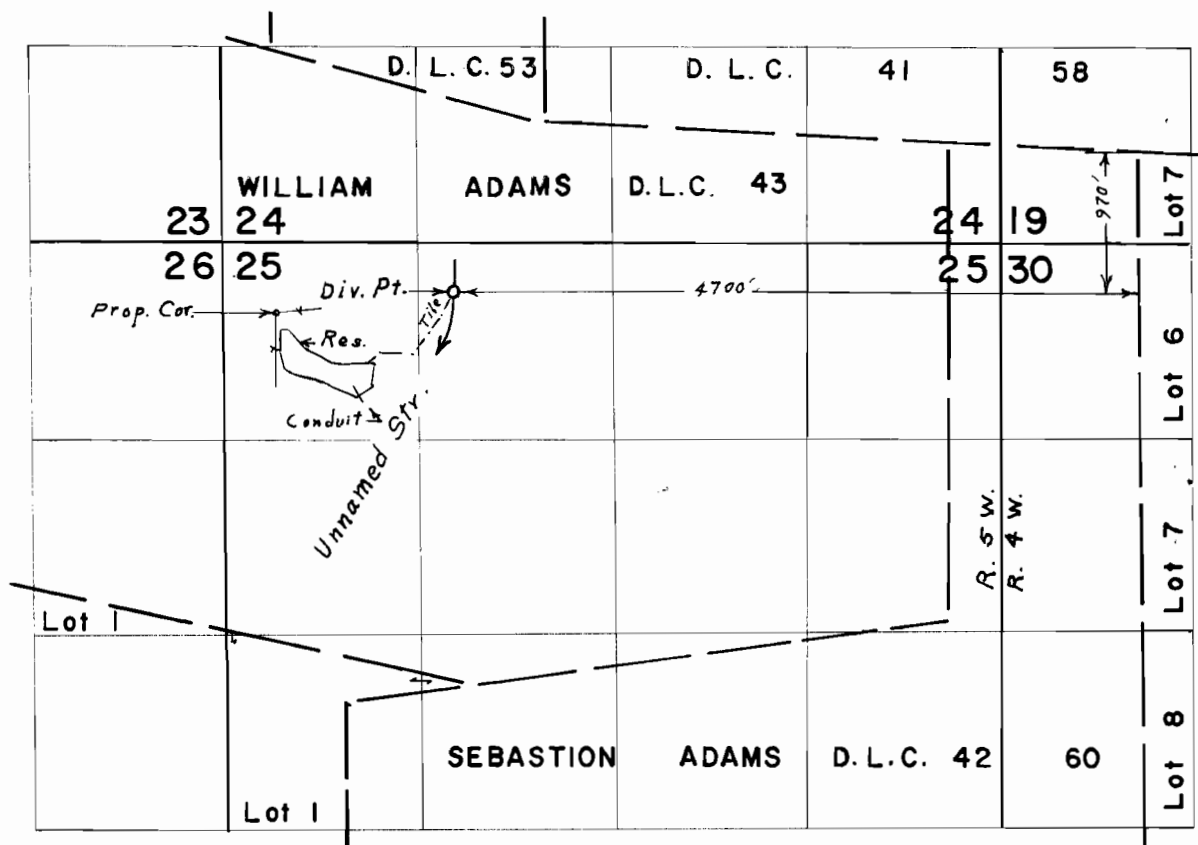

## FINAL PROOF SURVEY

UNDER

R-47 559

R-5729

47 560

35610

R-46 616

R-5570

Application No. 46617 Permit No. 34834

IN NAME OF

VICTOR THUMBERG

Surveyed Oct. 28, 1971, by L. E. Gould