


T. 4 S. R. 1 E. W. M.

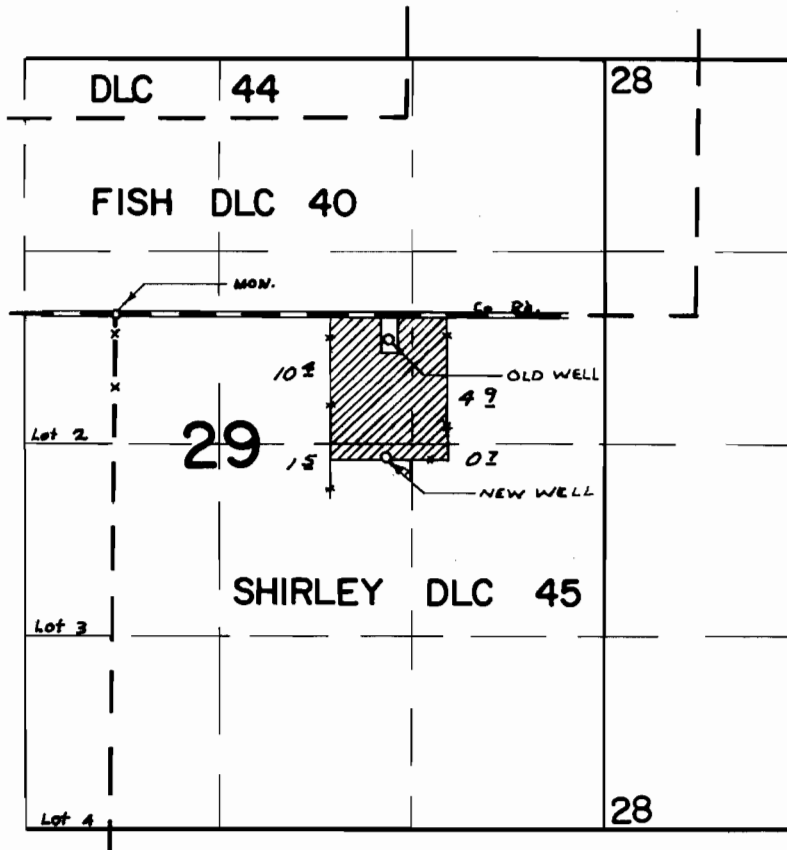

WELL LOC. 160' S. & 1870' E. FROM NW COR. SHIRLEY DLC 45
 WELL LOC. 980' S. & 1860' E. FROM NW COR. SHIRLEY DLC 45

FINAL PROOF SURVEY UNDER

G-5088 G- 4803
 Application No. G-3823 Permit No. G-3604
 IN NAME OF

THE ELI LILLY & COMPANY

Surveyed SEP. 18 1971, by R. MUCKEN