


T.4S.R.3E.W.M.

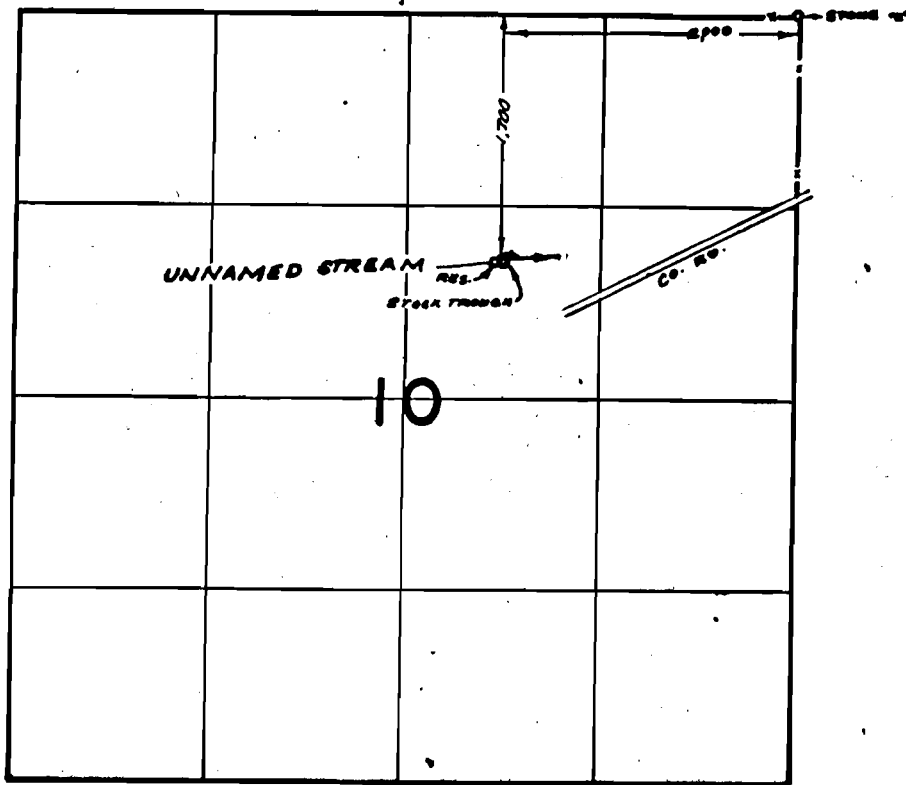

**FINAL PROOF SURVEY**  
UNDER

Application No. *38920* Permit No. *29603*  
*R-22752* *R-2274*  
IN NAME OF

JACK & VIRGE BURTON

Surveyed *May 20* 19*71*., by *R. MURKIN*.