


# T.4S.R.3E.W.M.

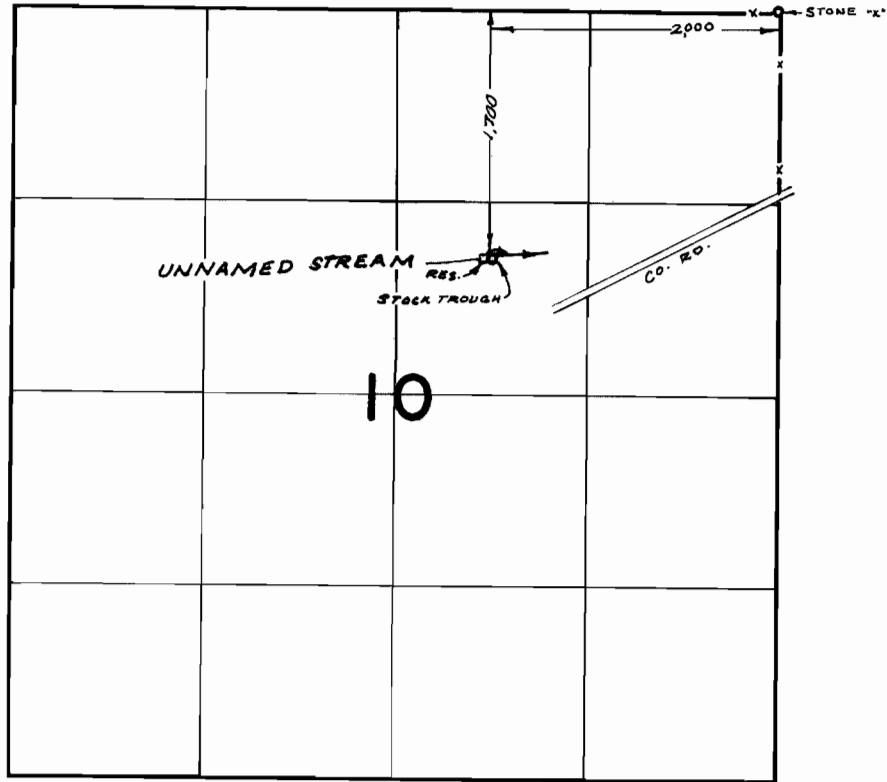

10

## FINAL PROOF SURVEY UNDER

Application No. <sup>38920</sup>~~R-22752~~ Permit No. <sup>29603</sup>~~R-2274~~  
IN NAME OF

JACK & VIRGE BURTON

Surveyed May 20 1971., by R. MURKEN.