


T. 3S. R. 1E. W.M.

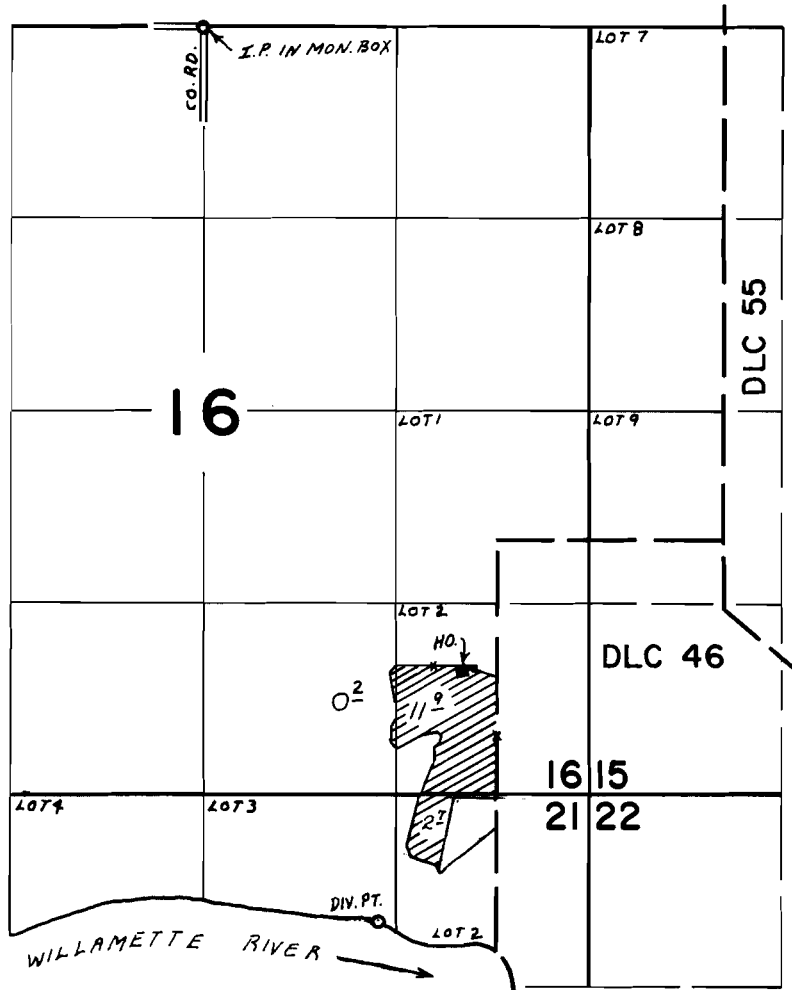

DIV. PT. LOC. 6160'S. & 1200'E. FROM N¹/₄ COR. SEC. 16

FINAL PROOF SURVEY UNDER

Application No. 90731... Permit No. 30237...
IN NAME OF

RAYMOND G. ASCHE

Surveyed NOV. 13 1970, by L. E. GOULD...