


T. 4 S. R. 3 E. W. M.

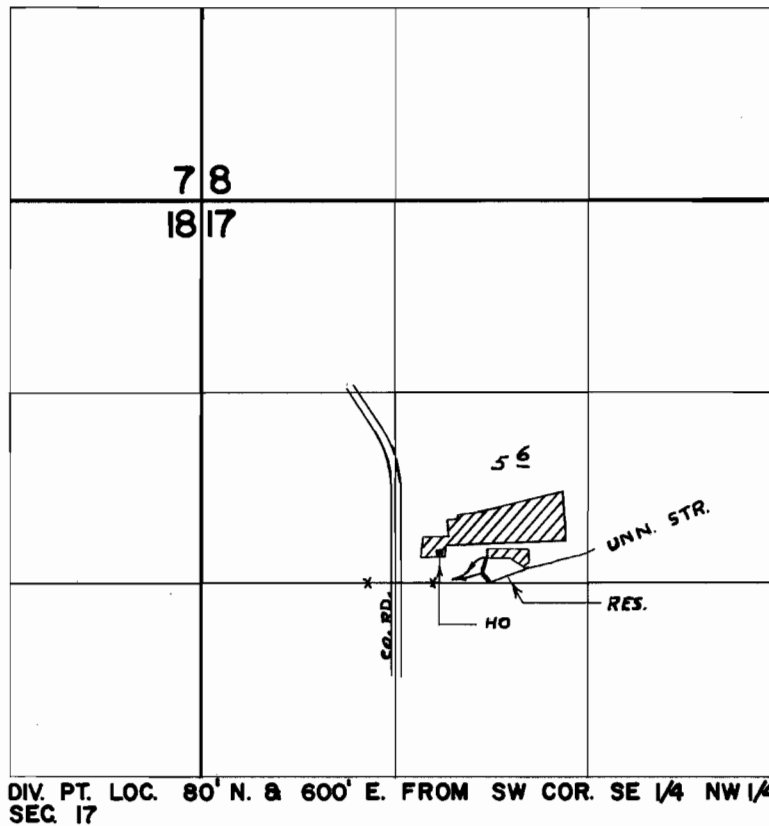

FINAL PROOF SURVEY
UNDER

R 41396 R 4668
Application No. 41740 Permit No. 30965
IN NAME OF

JAMES R. & LEAH V. WHITMORE

Surveyed APR 30, 1971, by R. MUCKEN