


T 2 S. R. 2 E. W. M.

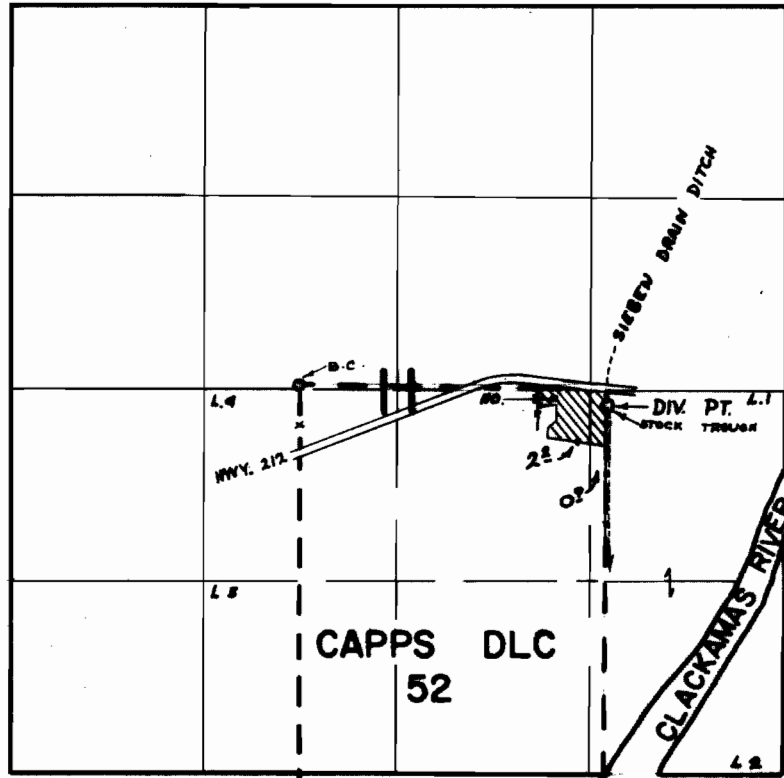

DIV. PT. LOC. 140' S & 2100' E FROM NW COR. CAPPS DLC 52

FINAL PROOF SURVEY
UNDER

Application No. 42699... Permit No. 31904...
IN NAME OF

MANUEL E. & OR GRACE A. MITCHELL

Surveyed NOV. 18, 1971, by R. MUCKEN.....