


T 2 S. R 4 & 5 E. W. M.

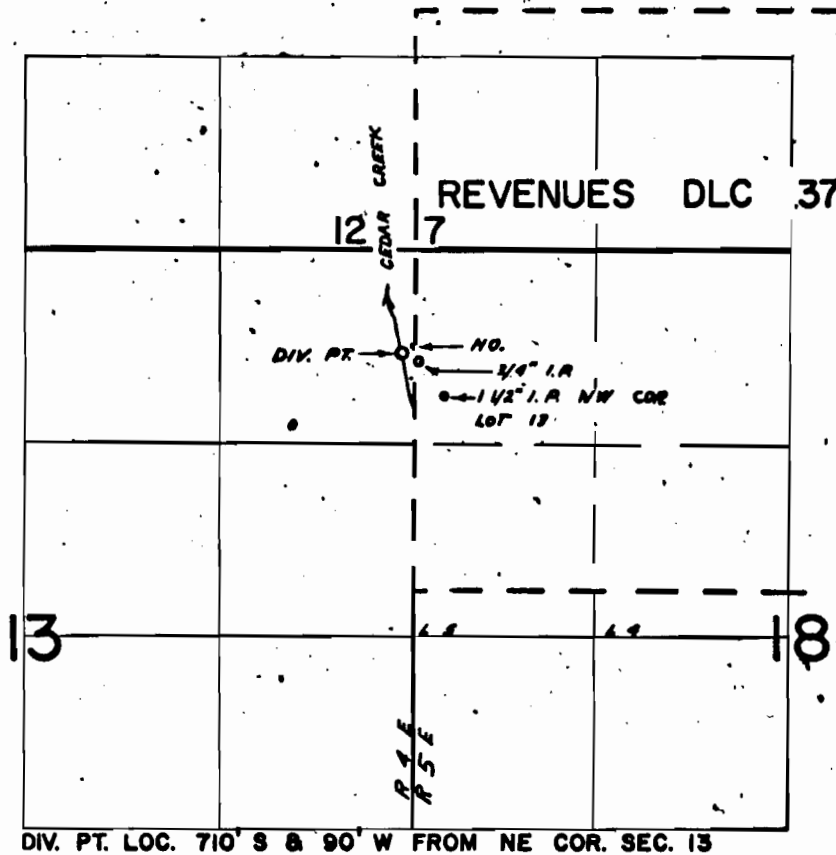

FINAL PROOF SURVEY UNDER

Application No. 47284 Permit No. 34795...
IN NAME OF

EUGENE W. DeSYLVIA

Surveyed NOV. 19, 1971, by R. MUCKEN