


# T. 3. S. R. 1 E. W. M.

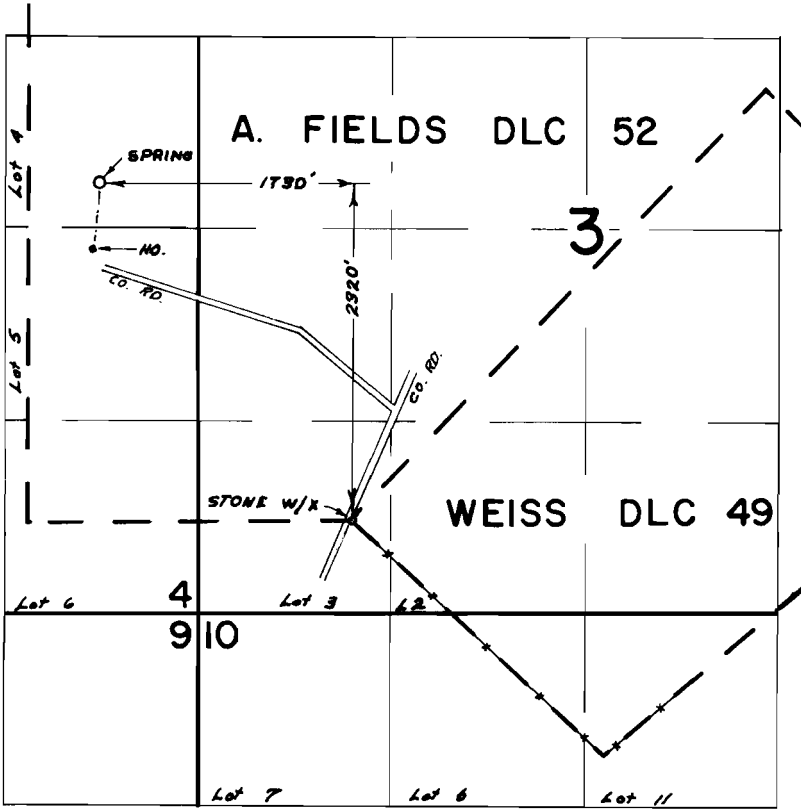

## FINAL PROOF SURVEY UNDER

Application No. 46707... Permit No. 34903...  
IN NAME OF

.....BEVERLY A. OATFIELD.....

Surveyed OCT. 28, 1971., by R. MUCKEN.....