


T. 4 N. R. 7 W. W. M.

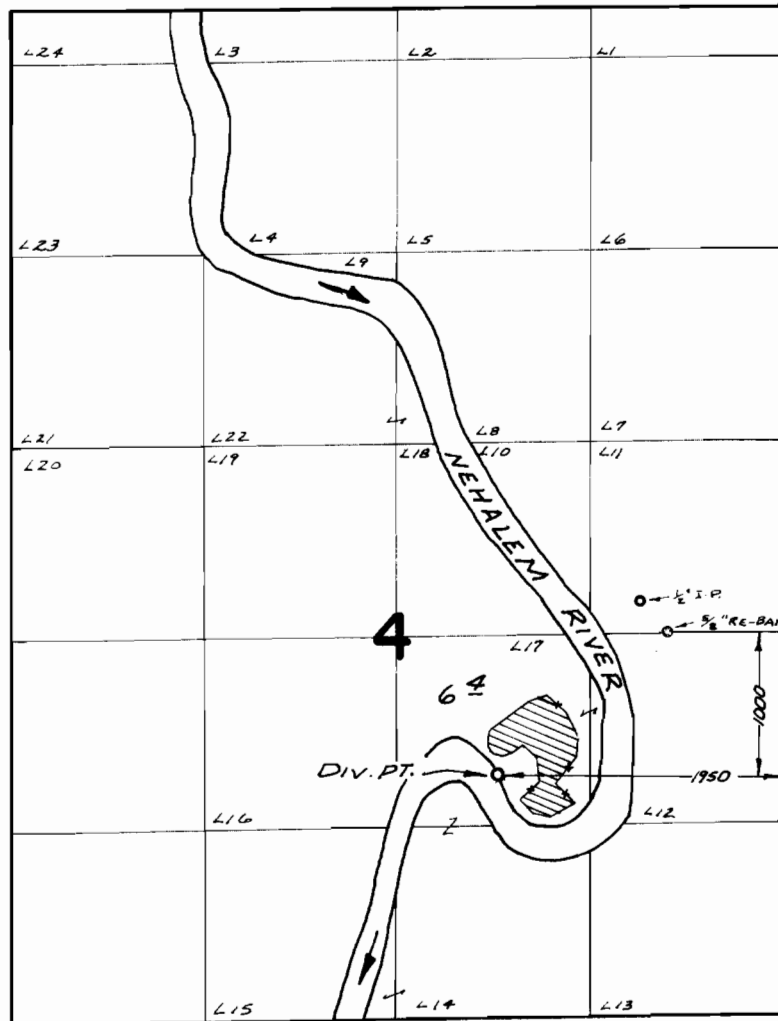

FINAL PROOF SURVEY
UNDER

Application No. 41756 Permit No. 31171
IN NAME OF

O. C. SVEHAUG

Surveyed JULY 23, 1971, by G. BACA