


T.25S.R.5W.W.M.

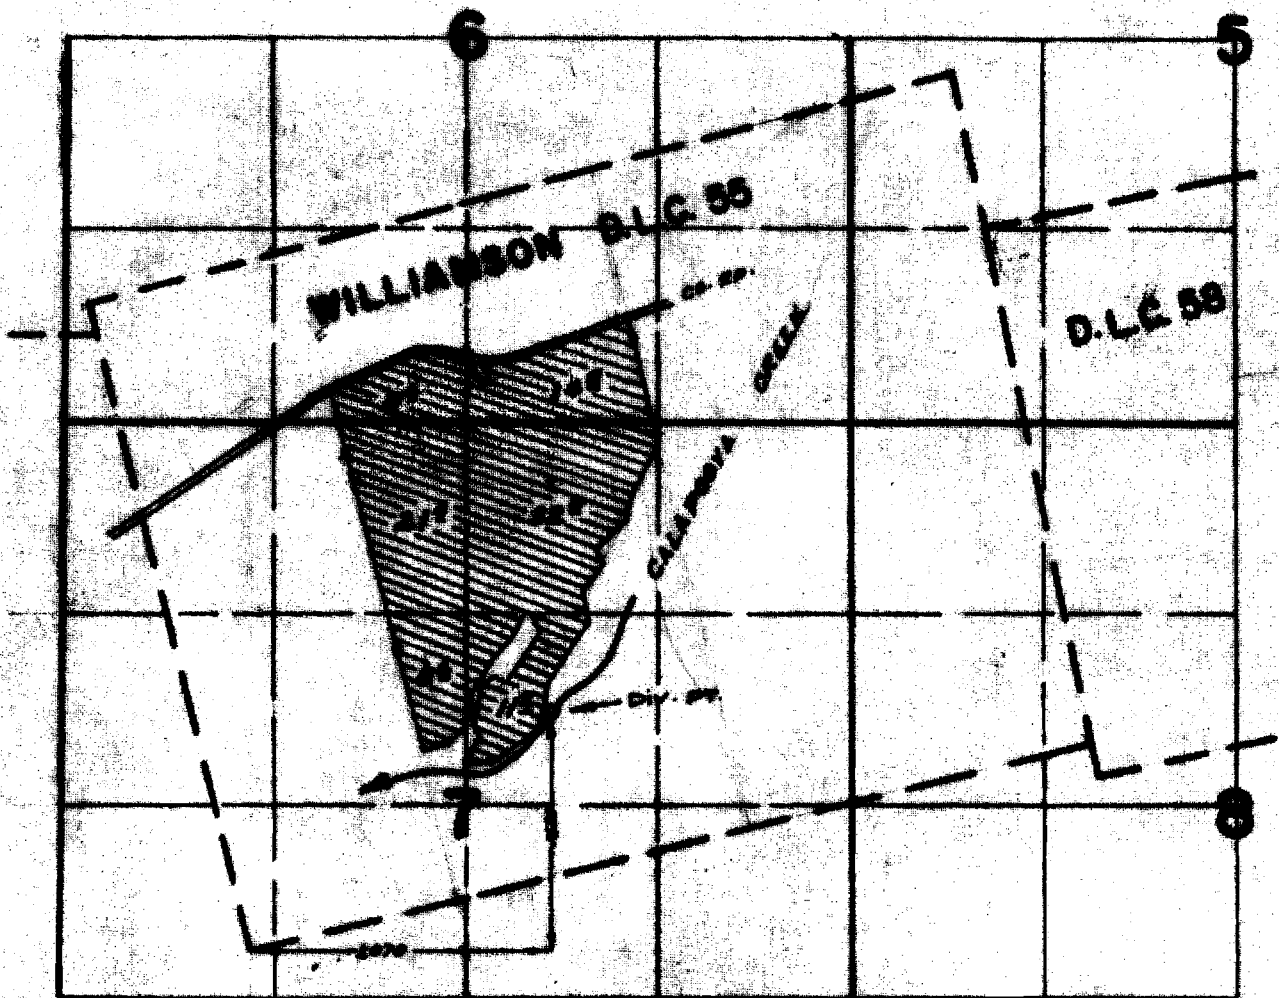


FINAL PROOF SURVEY
UNDER

Application No. 48412 Form No. 31026
IN NAME OF

FREDERICK J. MINCH

Surveyed APR 14, 1971 by G. BACA

T. 25S. R. 5W. W.M.

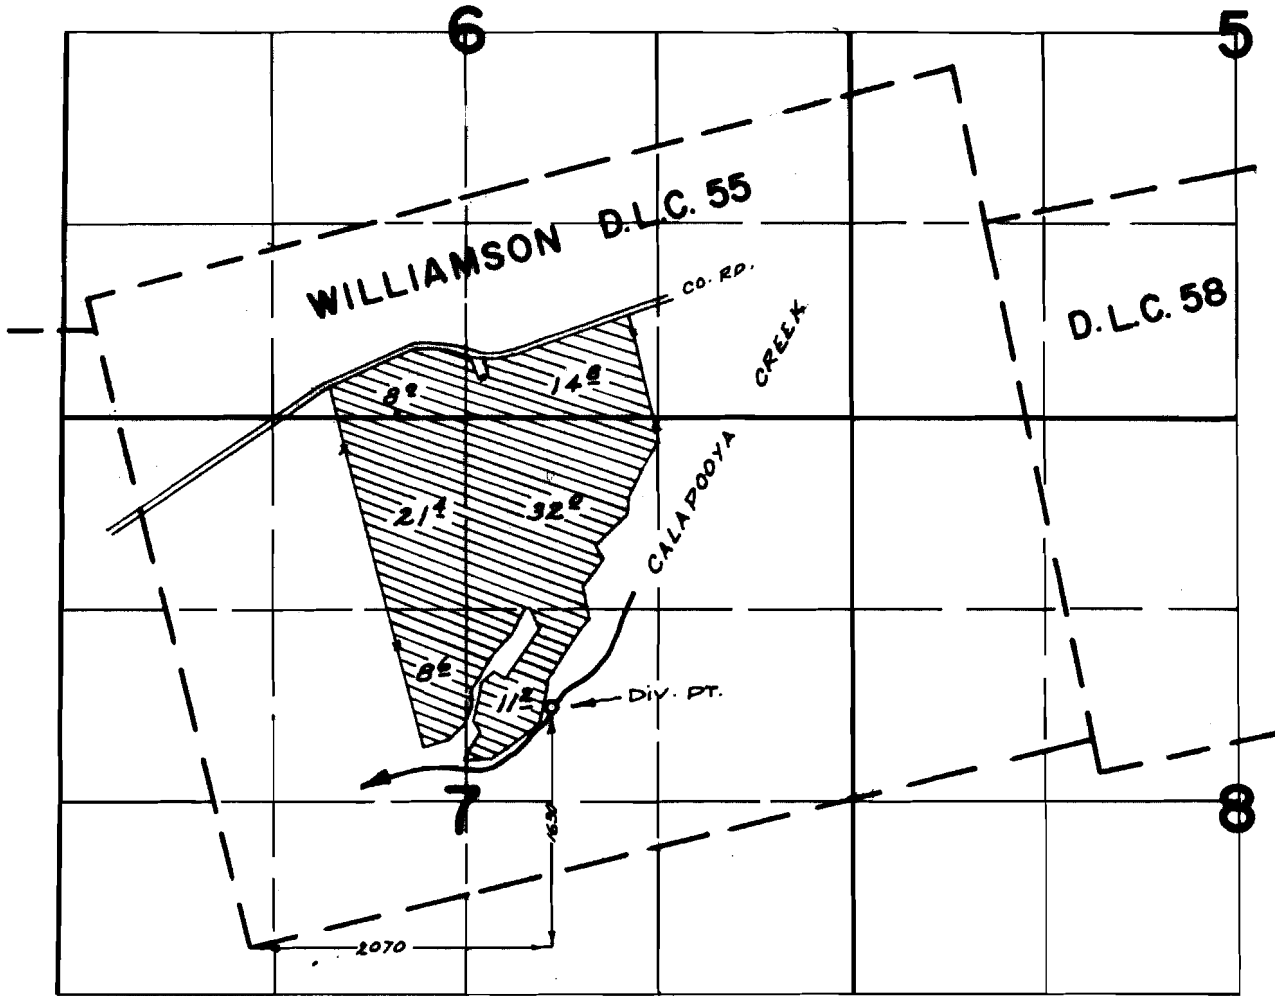

FINAL PROOF SURVEY
UNDER

Application No. 12013..... Permit No. 31046.....
IN NAME OF

FREDERICK J. MINICH.....

Surveyed APR. 14, 1971., by G. BACA.....