


T. 25S.R.6W.W.M.

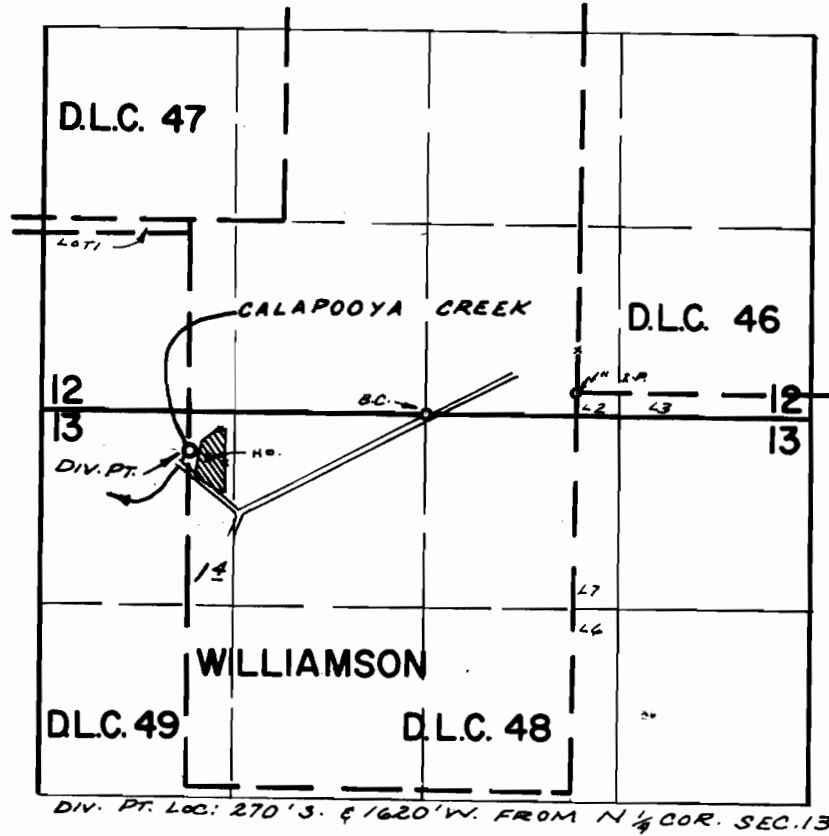

FINAL PROOF SURVEY UNDER

Application No. ~~43458~~ Permit No. 32506
IN NAME OF

LEON G. & ALICE M. MILLOTT

Surveyed APR. 15, 1971, by G. BACA