


# T.25S.R.5W.W.M.

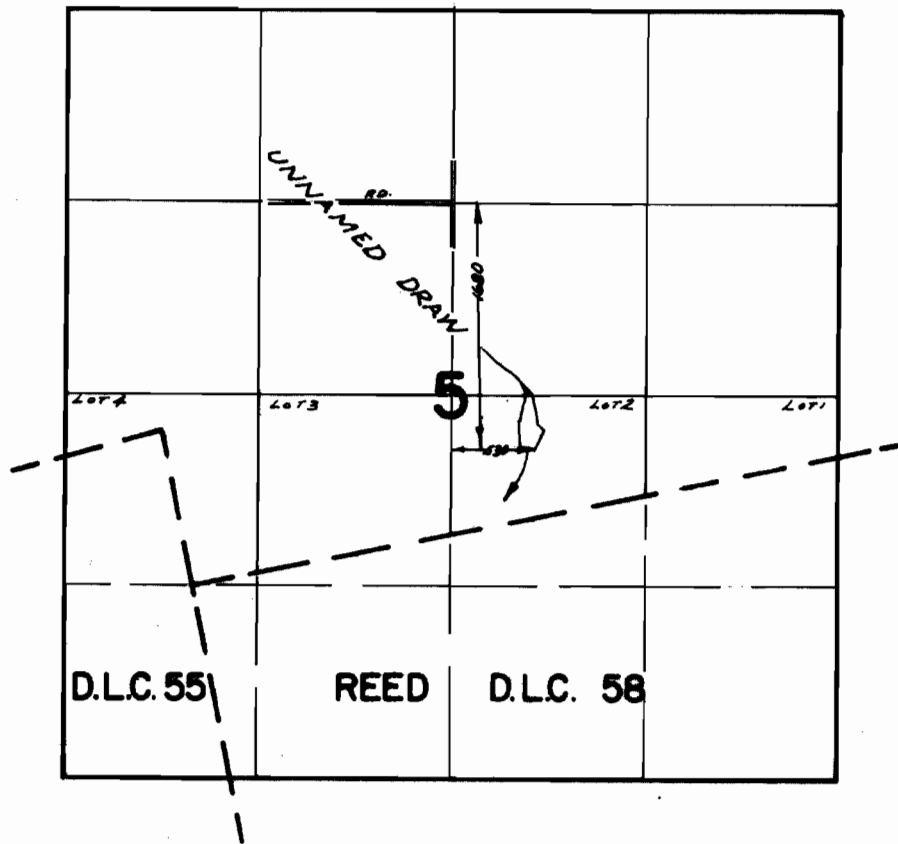

## FINAL PROOF SURVEY UNDER

Application No. ~~R. 26507~~ Permit No. ~~R. 5544~~  
IN NAME OF

ED WEST

Surveyed APR. 12, 1971, by G. BACA