


P. 27433

38949

T. 7 S. R. 28 E. W. M.

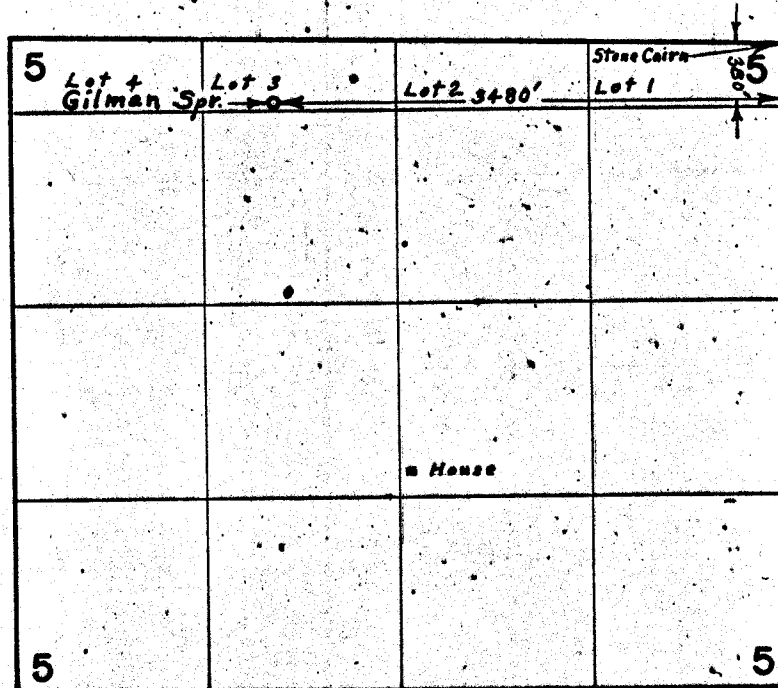

FINAL PROOF SURVEY.
UNDER

Application No. 34990 Permit No. 27433
IN NAME OF

ELICK ANDREW HUFF

Surveyed July 22, 1971, by L. E. Gould