


T10S. R. 15E. W.M.

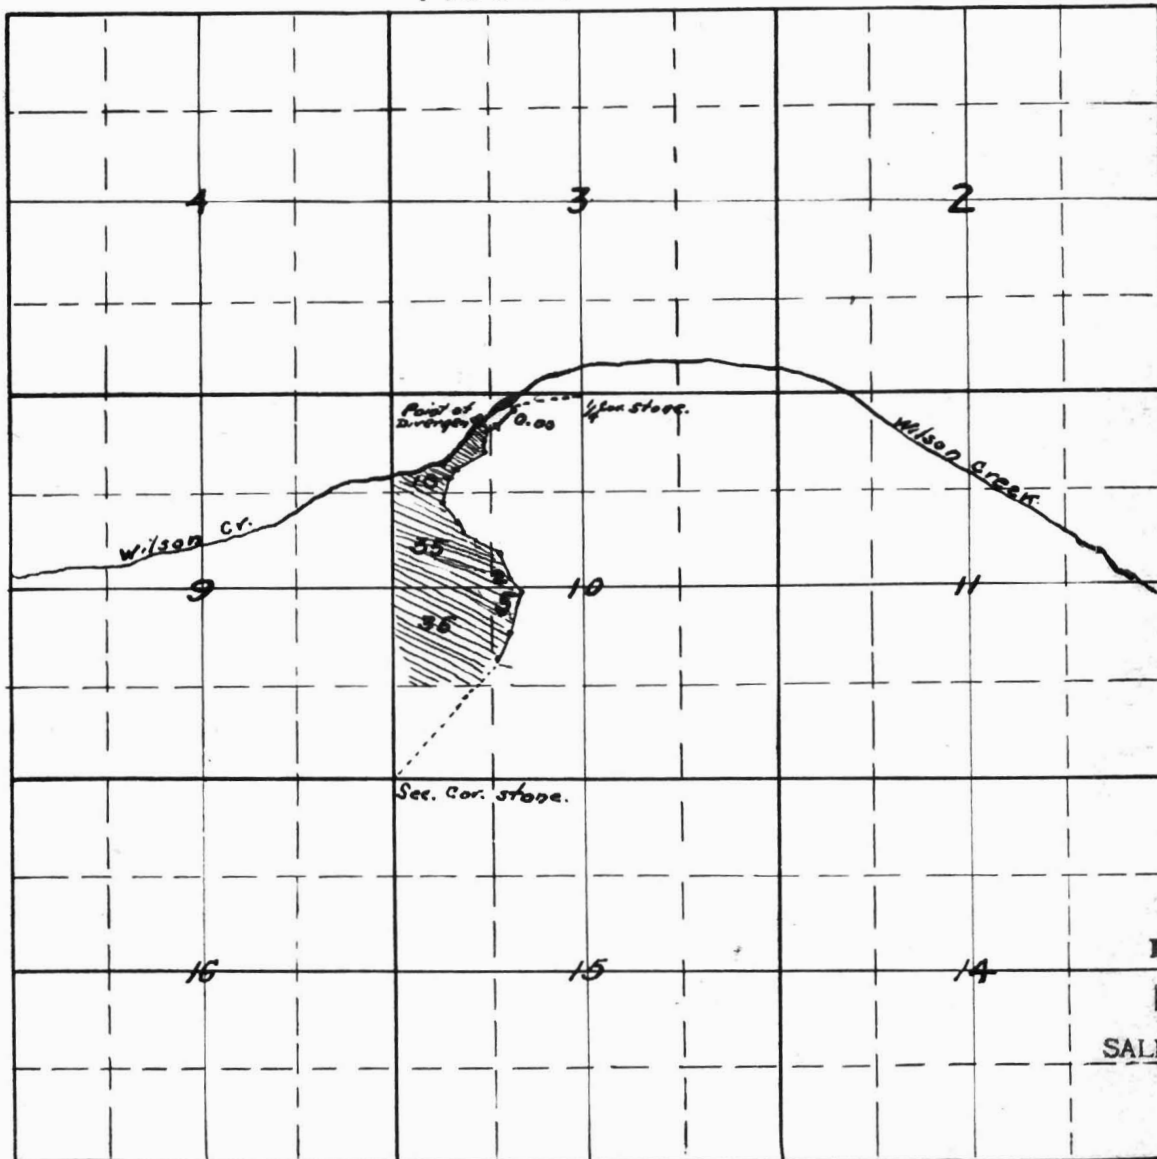

RECEIVED

MAR 12 1914

SALEM, OREGON,

Application
Permit No

CHALMER T. BRADFORD

DITCH.

Scale 40 chs. - 1 inch.

Field Notes.

0.00	N77°15'E	16.81	—	1st Con	24.41	S4°40'E	5.14	chs.
	S38°37'W.	4.82	chs.		29.55	S34°32'E	3.97	
4.82	S71°13'W	2.02			33.52	S78°27'E	4.74	
6.84	S31°45'W.	1.34			38.26	S7°58'E	6.06	
8.18	S6°16'W	1.92			44.32	S30°45'E	3.77	
10.10	S58°03'W	5.90			48.09	S7°07'W	10.85	
16.00	S48°31'W	1.37			58.94	S30°21'W	3.06	to End of Ditch
17.37	S1°38'E	7.04			62.00	S38°39'W	33.14	to Cor.

Prineville Ore. Feb. 23 1914.

I, F. L. Phoenix, of Redmond, Oregon, do hereby certify that this map was made from notes of an actual survey made by me on February 17, 1914, and it correctly represents the works described in the accompanying application, together with the location of streams, and has written thereon the area in each smallest legal subdivision which it is proposed to irrigate.

F. L. Phoenix
Surveyor.

FILED
2 1914

OREGON,

Application No. 3505
Permit No. 1926

3505-26

9222