


30998 38950

T.8 & 9 S. R. 27 E. W.M.

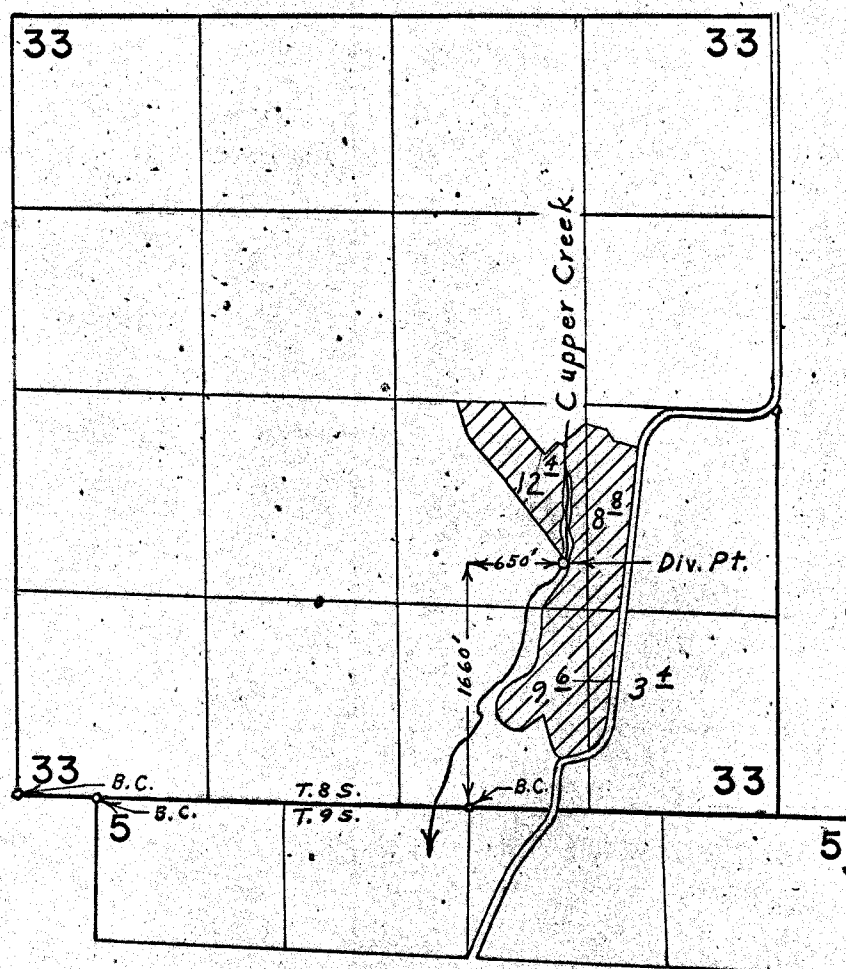

FINAL PROOF SURVEY.
UNDER

Application No. 41556 Permit No. 30998
IN NAME OF

SALLY & WILLARD REEVE

Surveyed July 17, 1971, by L. E. Gould