


32413  
38951

T 9 S. R. 27 E. W. M

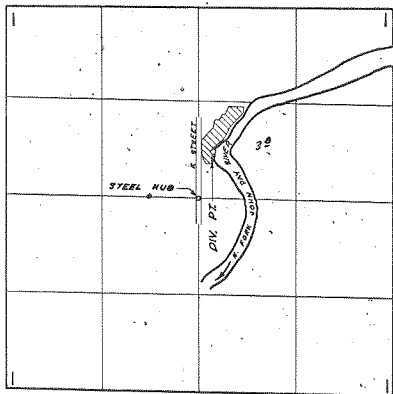

DIV. PT. LOC. 640' N & 200' E FROM CENTER SEC. 1

**FINAL PROOF SURVEY**  
UNDER

Application No. 43369... Permit No. 32413...  
IN NAME OF

..... **DARREL K. FARRENS** .....

Surveyed JULY 16, 1971., by L. E. Gould.....