


34330  
38952

# T. 8 & 9 S. R. 27 & 28 E. W.M.

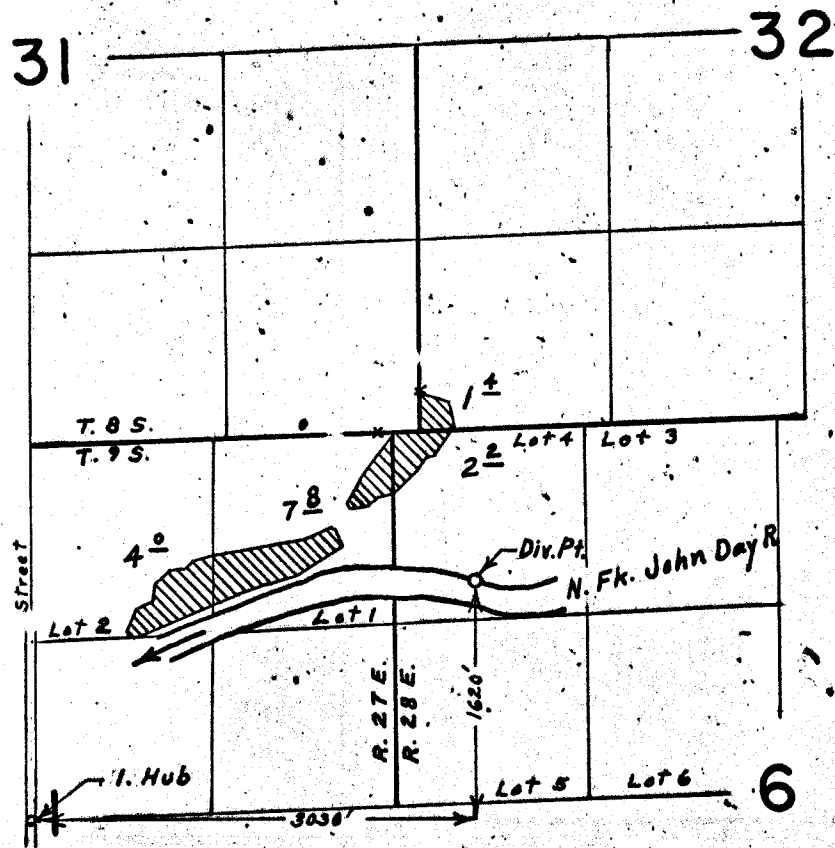

## FINAL PROOF SURVEY, UNDER

Application No. 45962. Permit No. 34330.  
IN NAME OF

GEORGE M. STUBBLEFIELD

Surveyed July 17, 1971, by L. E. Gould.