


# T.35S.R.3E.W.M.

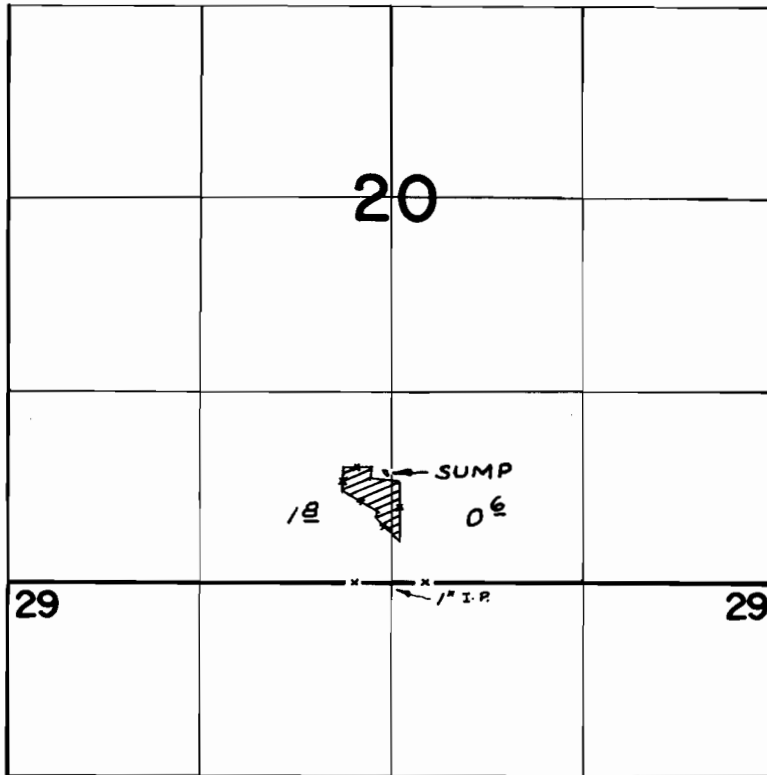

SUMP LOC: 750' N. & 50' W. FROM 3/4 COR. SEC. 20

## FINAL PROOF SURVEY UNDER

Application No. G-3312 Permit No. G-3084  
IN NAME OF

MRS. GEORGE ROWDEN

Surveyed AUG. 8, 1971, by G. BACA