


*Jenny Creek*

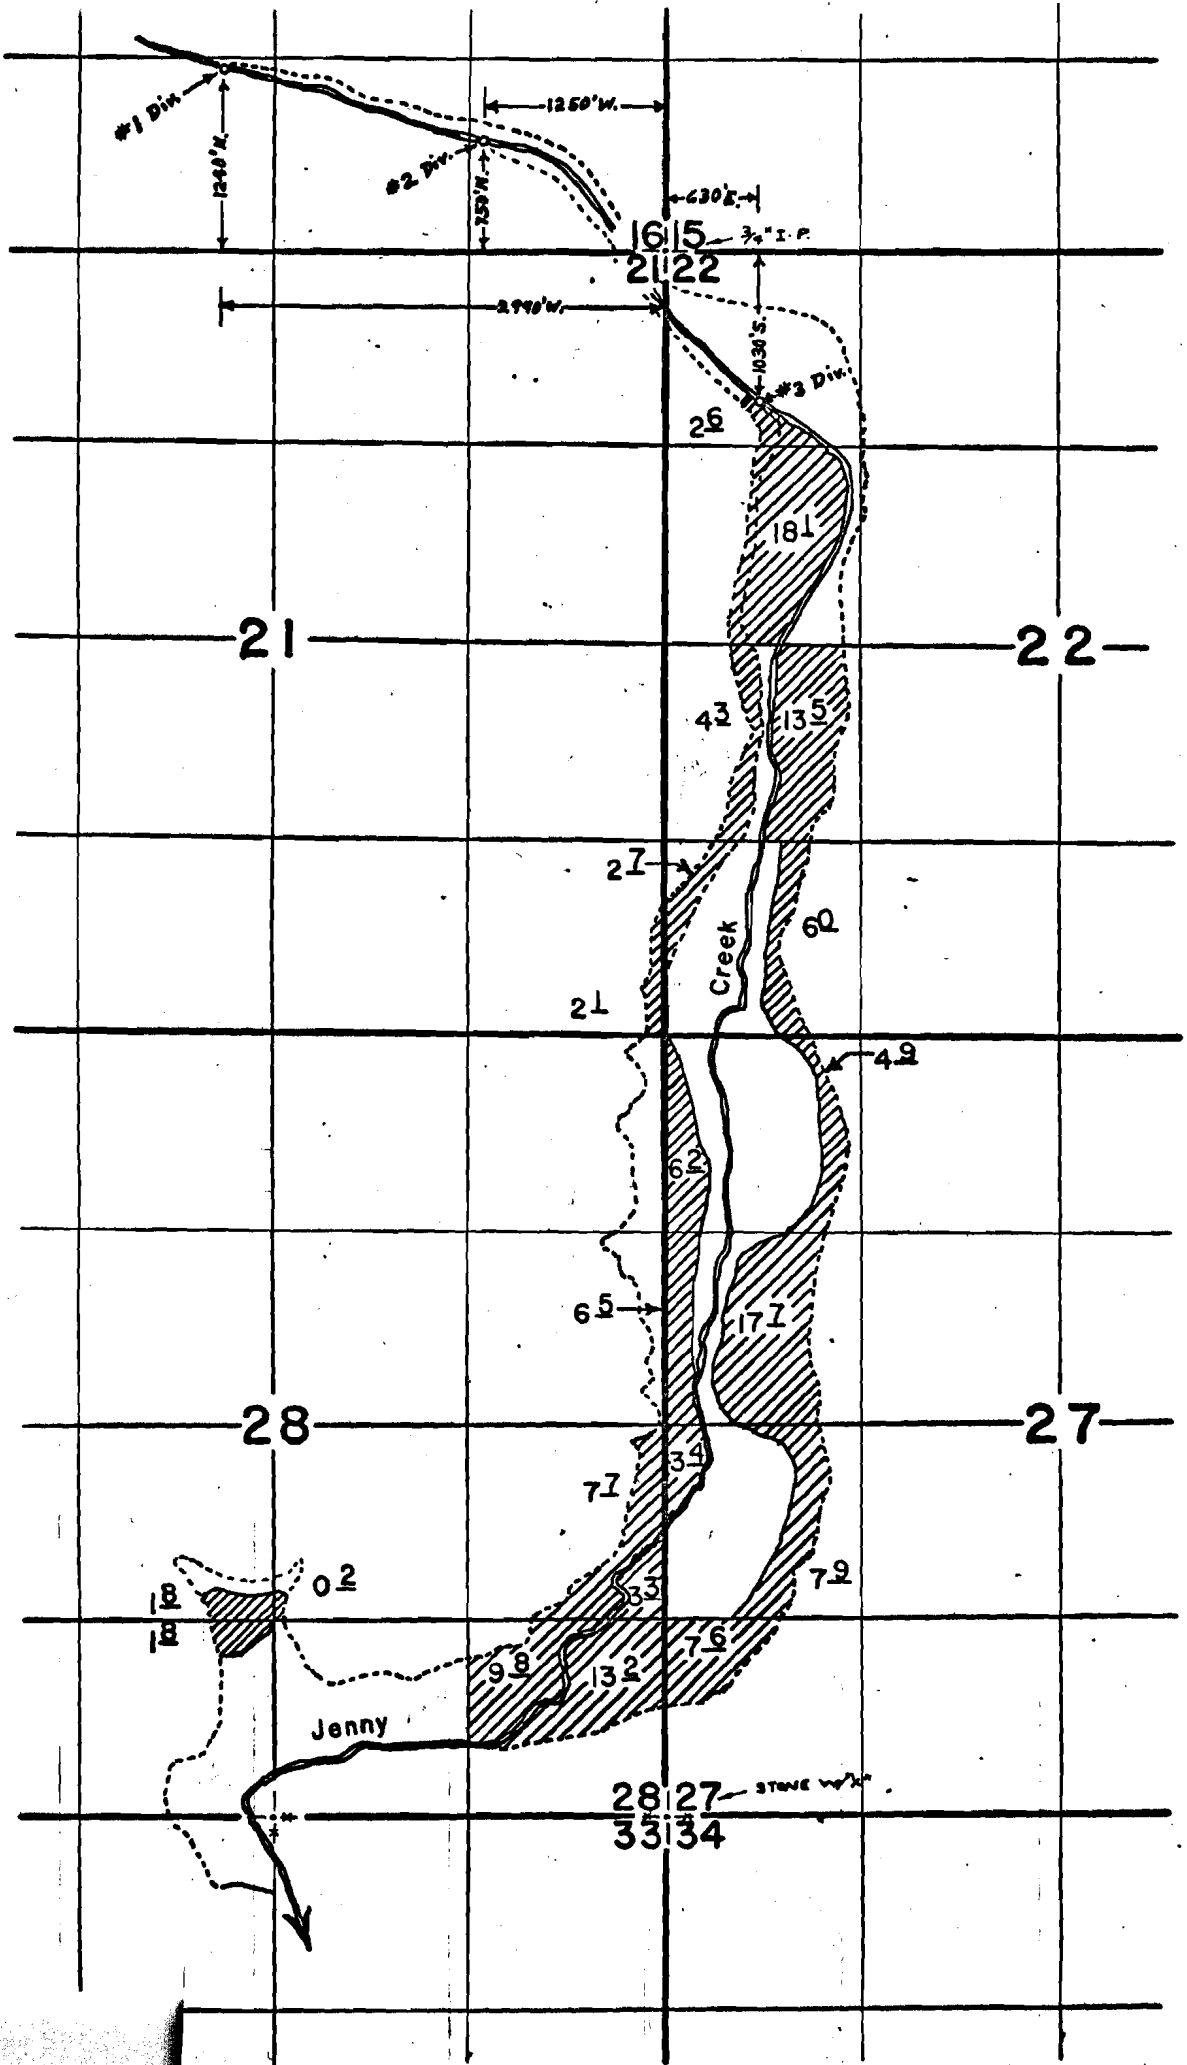

**FINAL PROOF SURVEY  
UNDER**

**Application No. 29825 Permit No. 23459  
IN NAME OF**

**JOHN MOSBY**