


T. 39S. R. 28 & 3W. W.M.

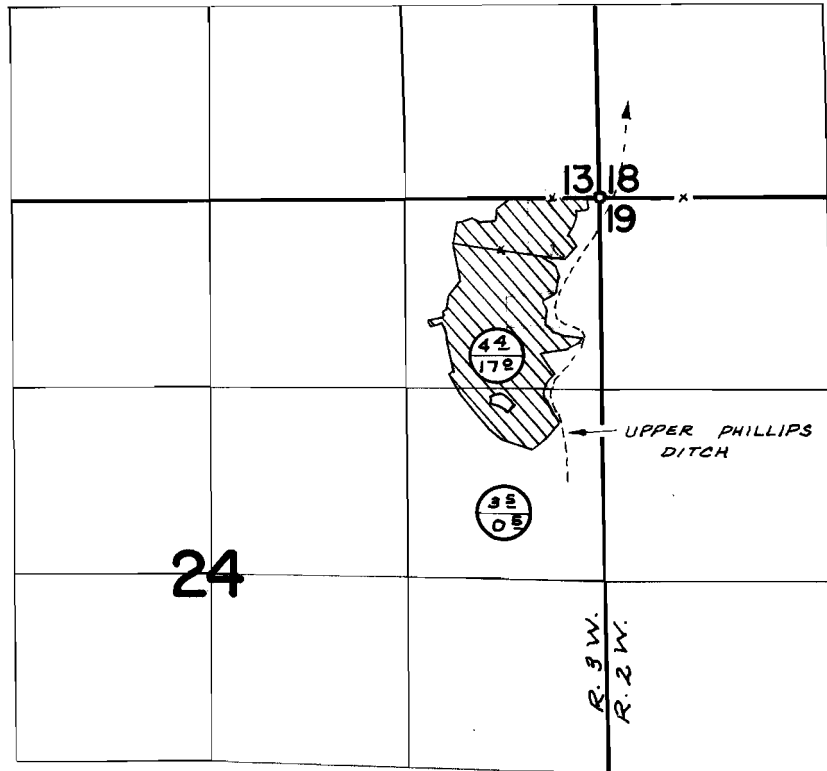

FROM APPLICANTS MAP - DIV. PT. LOC: 680'S. 89'W.
 FROM N¹/₄ COR. SEC. 29, T. 39 S. R. 2 W. W. M.

⊖ → CERT. 37369
 → APPL. 39952

FINAL PROOF SURVEY UNDER

Application No. 39952 Permit No. 29734
 IN NAME OF

E. E. SHARP & JOHN W. EEK

Surveyed AUG. 11, 1971, by G. BACA