


T. 39S. R. 3W. W.M.

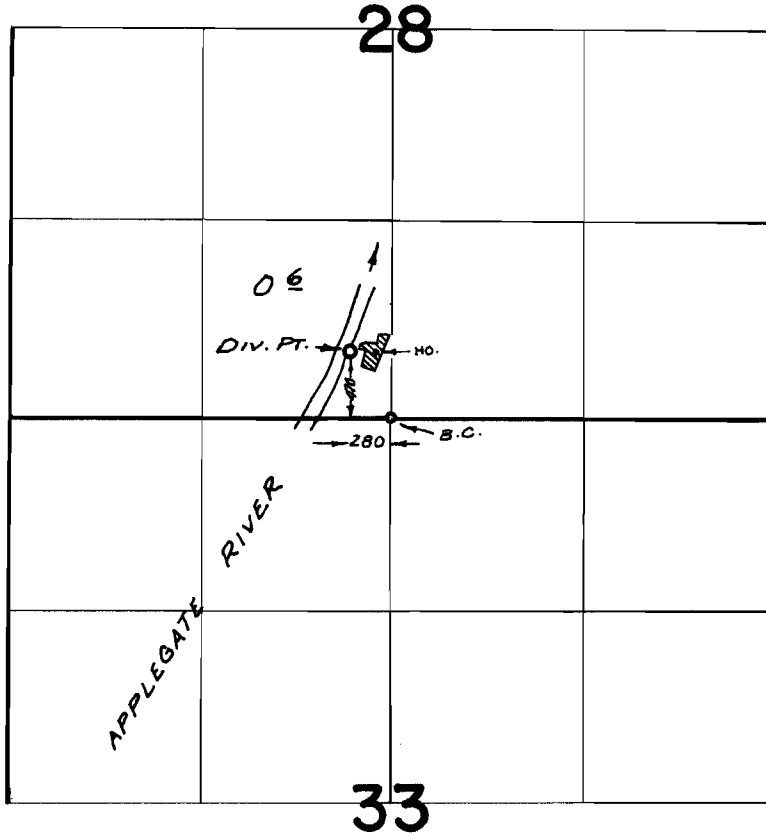

FINAL PROOF SURVEY
UNDER

Application No. 38655 Permit No. 28766
IN NAME OF

FRED & DOROTHY NOACK

Surveyed AUG. 10, 1971, by G. BACA